

City of Prince George

HISTORY SHEET

PID: 029-840-660

Scale: 1:1500

Legal: LOT 8

D.L.: 748

PLAN: EPP46674

Address: 6989 BOUNDARY CRT

Sanitary Connection:#	SIZE: 150mmØ	MATERIAL: PVC	INV. AT R 669.18m	CONNECTED
-----------------------	--------------	---------------	-------------------	-----------

Water Connection:#	SIZE: 150mmØ	MATERIAL: PVC	INV. AT R 668.14m	CONNECTED
--------------------	--------------	---------------	-------------------	-----------

Storm Connection:#	SIZE: 250mmØ	MATERIAL: PVC	INV. AT R 664.30m	CONNECTED
--------------------	--------------	---------------	-------------------	-----------

Cash Receipt No's:	WATER	SANITARY	STORM
--------------------	-------	----------	-------

CURB FROM PROPERTY LINE	6m	PAVEMENT WIDTH	13m
-------------------------	----	----------------	-----

HYDRO	75mm DB2	U/G CONNECTION	✓
-------	----------	----------------	---


TELEPHONE	100mm DB2	U/G CONNECTION	✓
-----------	-----------	----------------	---

GAS	42 PROP/P.E.		
-----	--------------	--	--

Information Sheets: REF. DWGS. L&M ENGINEERING LTD. JOB. 1282-11 DWGS.

Comments: CS CURB STOP CO CLEAN OUT WAT WATER SERVICE STM STORM SERVICE SAN SANITARY SERVICE HYDRO SERVICE CABLE SERVICE TELECOMMUNICATIONS GAS GAS ELECTRICAL

THE INFORMATION CONTAINED HEREIN IS FOR INTERNAL USE ONLY.
NOT TO BE RELIED UPON UNLESS CONFIRMED BY THE SITE INSPECTION AND/OR INVESTIGATION

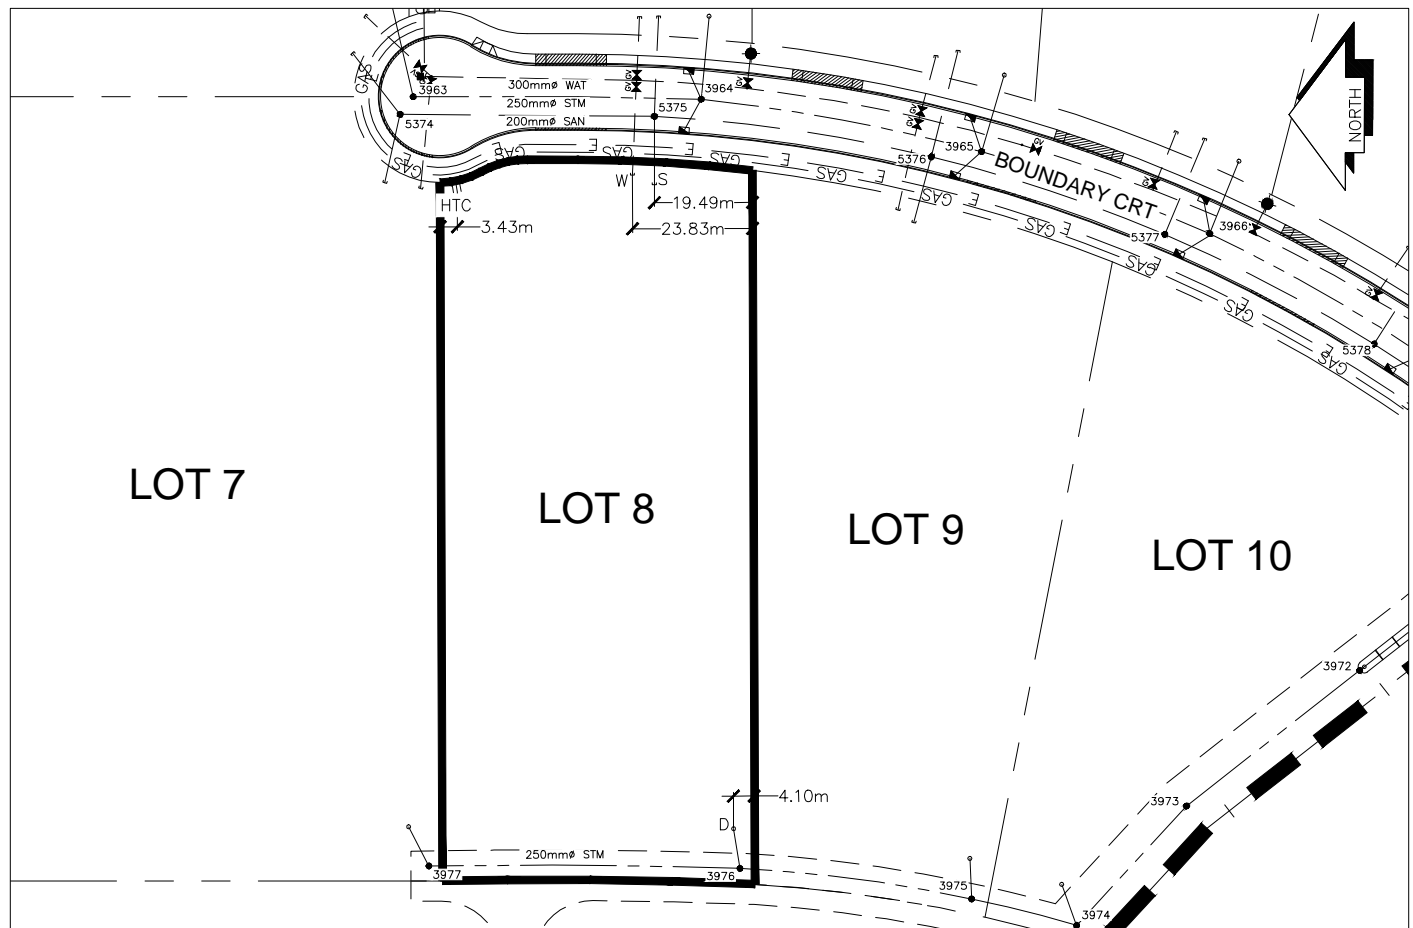

SANITARY, STORM & WATER SERVICE INVERTS	SANITARY	WATER	STORM
1. Lot service installed directly into San. M.H. <u>5375</u>	N/A	N/A	N/A
1. Lot service installed directly into Stm. M.H. <u>3964</u>	N/A	N/A	N/A
2. Main Size at connection point is	MH	300mmØ	MH
3. Invert of service at main conn. stub point is	669.12m	668.02m	664.11m
4. Invert at service end is	669.21m	668.16m	664.30m
5. Cover at property line in meters	1.90m	2.96m	0.00m
6. Survey Date:AUG 2014 Book Ref.:1282-11 By:L&M ENGINEERING LTD			

SANITARY HISTORY:

DATE INSTALLED: AUG 2014

INSTALLED BY: BOUNDARY ROAD BUILDERS LTD

WATER HISTORY:

DATE INSTALLED: AUG 2014

INSTALLED BY: BOUNDARY ROAD BUILDERS LTD

STORM HISTORY:

DATE INSTALLED: AUG 2014

INSTALLED BY: BOUNDARY ROAD BUILDERS LTD
