

City of Prince George

HISTORY SHEET

PID: 029-840-678

Scale: 1:1500

Legal: LOT 9

D.L.: 748

PLAN: EPP46674

Address: 7048 BOUNDARY CRT

Sanitary Connection:#	SIZE: 150mmØ	MATERIAL: PVC	INV. AT R 668.93m	CONNECTED
-----------------------	--------------	---------------	-------------------	-----------

Water Connection:#	SIZE: 150mmØ	MATERIAL: PVC	INV. AT R 667.88m	CONNECTED
--------------------	--------------	---------------	-------------------	-----------

Storm Connection:#	SIZE: 250mmØ	MATERIAL: PVC	INV. AT R 663.99m	CONNECTED
--------------------	--------------	---------------	-------------------	-----------

Cash Receipt No's:	WATER	SANITARY	STORM
--------------------	-------	----------	-------

CURB FROM PROPERTY LINE	6m	PAVEMENT WIDTH	13m
-------------------------	----	----------------	-----

HYDRO	75mm DB2	U/G CONNECTION	✓
-------	----------	----------------	---


TELEPHONE	100mm DB2	U/G CONNECTION	✓
-----------	-----------	----------------	---

GAS	42 PROP/P.E.		
-----	--------------	--	--

Information Sheets: REF. DWGS. L&M ENGINEERING LTD. JOB. 1282-11 DWGS.

Comments: CS CURB STOP CO CLEAN OUT WAT WATER SERVICE STM STORM SERVICE SAN SANITARY SERVICE HYDRO SERVICE CABLE SERVICE TELECOMMUNICATIONS GAS GAS ELECTRICAL

THE INFORMATION CONTAINED HEREIN IS FOR INTERNAL USE ONLY.
NOT TO BE RELIED UPON UNLESS CONFIRMED BY THE SITE INSPECTION AND/OR INVESTIGATION

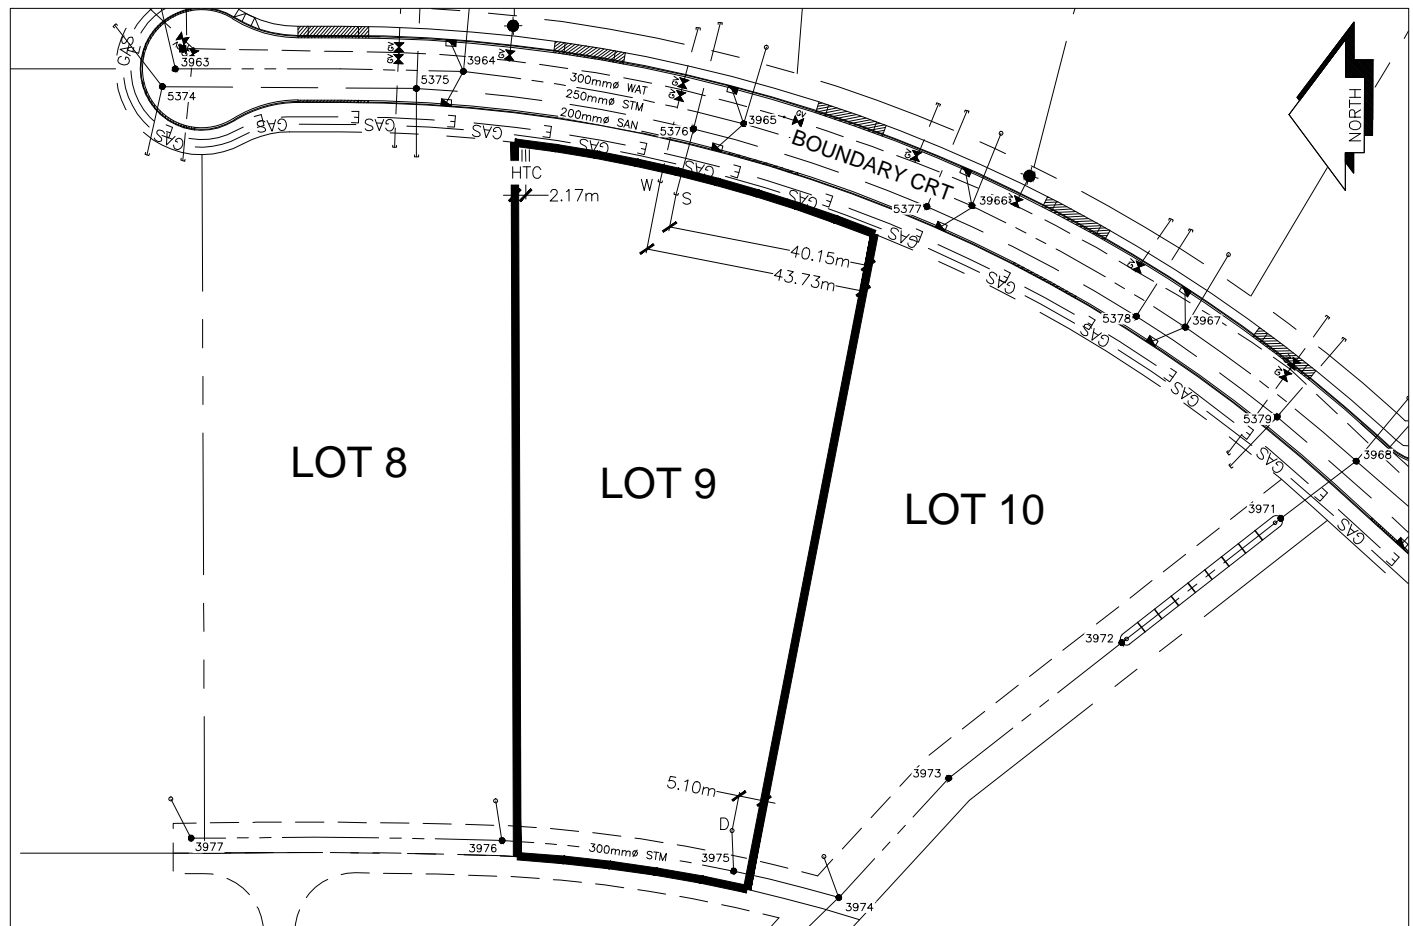

DATE INSTALLED: AUG 2014

INSTALLED BY: BOUNDARY ROAD BUILDERS LTD

DATE INSTALLED: AUG 2014

INSTALLED BY: BOUNDARY ROAD BUILDERS LTD

[illegible]