

City of Prince George

HISTORY SHEET

PID: 029-851-980

Scale: 1:500

Legal: LOT 2

D.L.: 2003

PLAN: EPP52840

Address: 1121 MONARCH CRT

Sanitary Connection:# SIZE: 100mmØ MATERIAL: PVC INV. AT R 676.44m CONNECTED

Water Connection:# SIZE: 19mmØ MATERIAL: COPPER INV. AT R 676.43m CONNECTED

Storm Connection:# SIZE: 100mmØ MATERIAL: PVC INV. AT R 676.45m CONNECTED

Cash Receipt No's: WATER SANITARY STORM

CURB FROM PROPERTY LINE 5m PAVEMENT WIDTH 10m

HYDRO 75mm DB2 U/G CONNECTION ✓

TELEPHONE 100mm DB2 U/G CONNECTION ✓


GAS 42 PROP/P.E.

Information Sheets: REF. DWGS. L&M ENGINEERING LTD. JOB. 1265-10 DWGS.

Comments: CS CURB STOP CO CLEAN OUT SDW WATER SERVICE STORM SERVICE SANITARY SERVICE HTC HYDRO SERVICE CABLE SERVICE TELECOMMUNICATIONS GAS GAS ELECTRICAL

THE INFORMATION CONTAINED HEREIN IS FOR INTERNAL USE ONLY.

NOT TO BE RELIED UPON UNLESS CONFIRMED BY THE SITE INSPECTION AND/OR INVESTIGATION

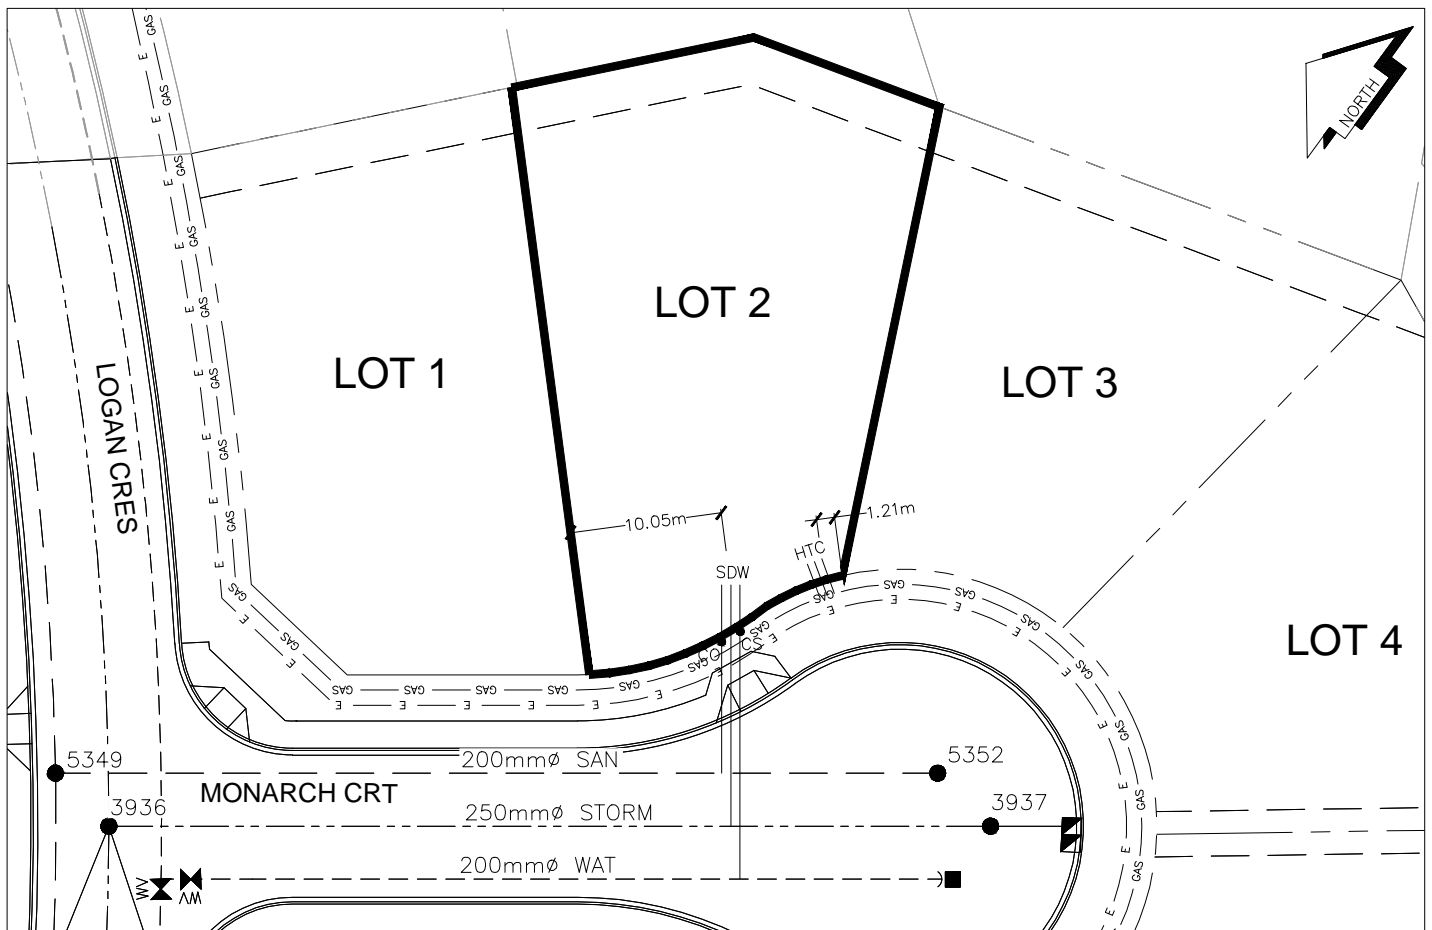

SANITARY, STORM & WATER SERVICE INVERTS	SANITARY	WATER	STORM
1. Distance from San. M.H. <u>5352</u> toward San. M.H. <u>5349</u> to lot service connection point is:	15.00m	N/A	N/A
1a.Distance from Stm. M.H. <u>3937</u> toward Stm. M.H. <u>3936</u> to lot service connection point is:	N/A	N/A	12.18m
2. Main Size at connection point is	200mmØ	200mmØ	250mmØ
3. Invert of service at main conn. stub point is	675.89m	675.53m	675.50m
4. Invert at service end is	676.63m	676.62m	676.63m
5. Cover at property line in meters	2.48m	2.57m	2.48m
6. Survey Date:AUG 2014 Book Ref.:1265-10 By:SHARP CONSTRUCTION			

SANITARY HISTORY:

DATE INSTALLED: AUG 2014

INSTALLED BY: SHARP CONSTRUCTION

WATER HISTORY:

DATE INSTALLED: AUG 2014

INSTALLED BY: SHARP CONSTRUCTION

STORM HISTORY:

DATE INSTALLED: AUG 2014

INSTALLED BY: SHARP CONSTRUCTION