

# City of Prince George

## HISTORY SHEET

PID: 029-852-030

Scale: 1:500

Legal: LOT 7

D.L.: 2003

PLAN: EPP52840

Address: 1118 MONARCH CRT

Sanitary Connection:# SIZE: 100mmØ MATERIAL: PVC INV. AT R 676.50m CONNECTED

Water Connection:# SIZE: 19mmØ MATERIAL: COPPER INV. AT R 676.45m CONNECTED

Storm Connection:# SIZE: 100mmØ MATERIAL: PVC INV. AT R 676.50m CONNECTED

Cash Receipt No's: WATER SANITARY STORM

CURB FROM PROPERTY LINE 5m PAVEMENT WIDTH 10m

HYDRO 75mm DB2 U/G CONNECTION ✓


TELEPHONE 100mm DB2 U/G CONNECTION ✓

GAS 42 PROP/P.E.

Information Sheets: REF. DWGS. L&M ENGINEERING LTD. JOB. 1265-10 DWGS.

Comments: CS CURB STOP SDW WATER SERVICE CO CLEAN OUT SDW STORM SERVICE SDW SANITARY SERVICE HYDRO SERVICE CABLE SERVICE TELECOMMUNICATIONS GAS GAS ELECTRICAL

THE INFORMATION CONTAINED HEREIN IS FOR INTERNAL USE ONLY.  
NOT TO BE RELIED UPON UNLESS CONFIRMED BY THE SITE INSPECTION AND/OR INVESTIGATION

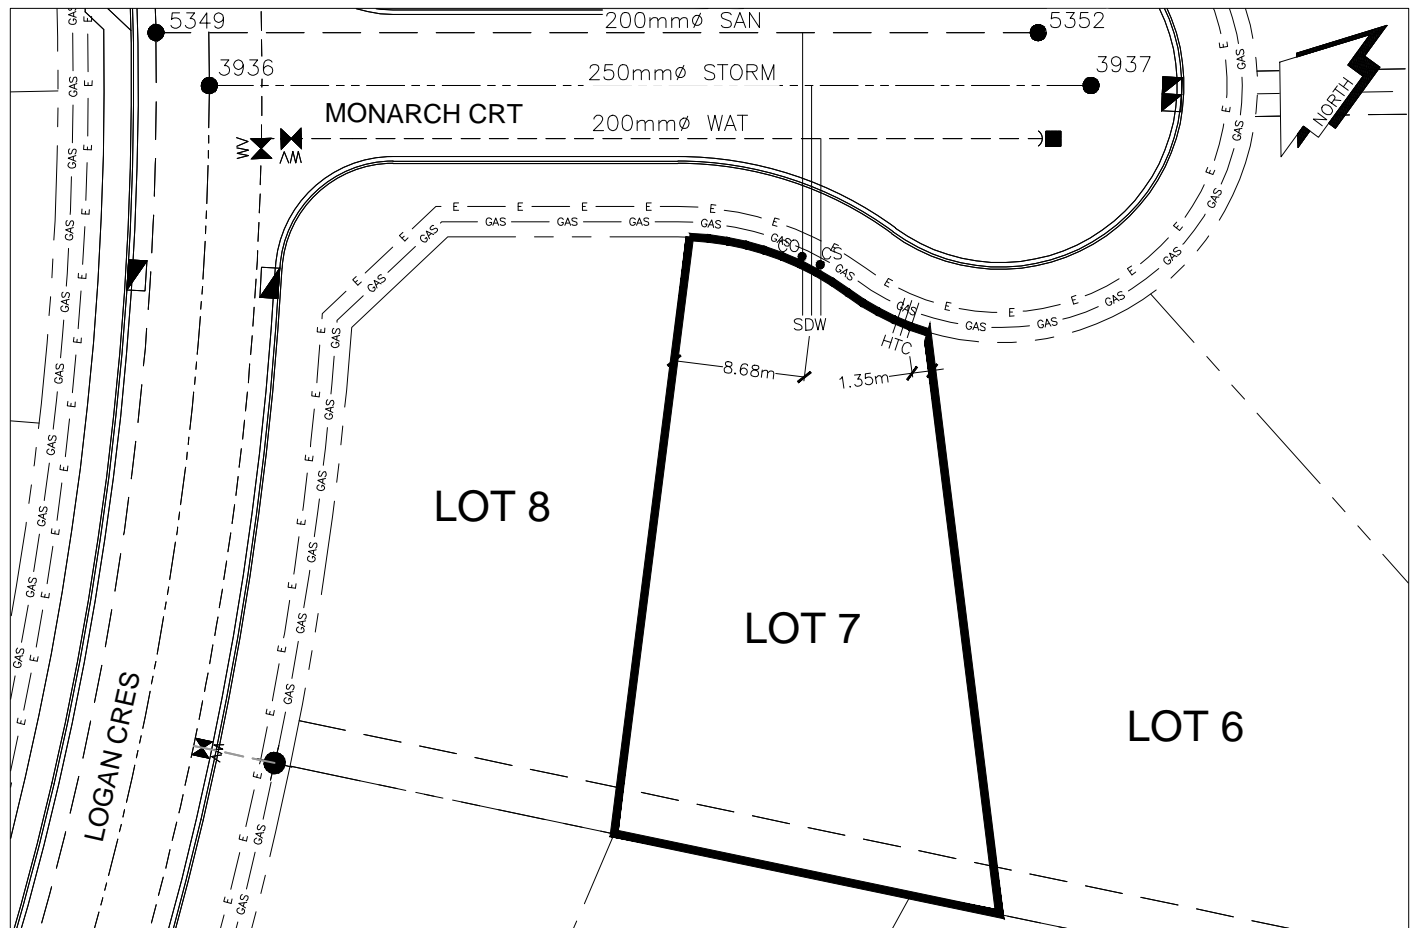

[illegible]

DATE INSTALLED: AUG 2014

INSTALLED BY: SHARP CONSTRUCTION

DATE INSTALLED: AUG 2014

---

INSTALLED BY: SHARP CONSTRUCTION

---

---

