

City of Prince George

HISTORY SHEET

PID: 029-852-072

Scale: 1:500

Legal: LOT 11

D.L.: 2003

PLAN: EPP52840

Address: 1133 MONTEITH CRT

Sanitary Connection:#	SIZE: 100mmØ	MATERIAL: PVC	INV. AT R 678.36m	CONNECTED
-----------------------	--------------	---------------	-------------------	-----------

Water Connection:#	SIZE: 19mmØ	MATERIAL: COPPER	INV. AT R 678.25m	CONNECTED
--------------------	-------------	------------------	-------------------	-----------

Storm Connection:#	SIZE: 100mmØ	MATERIAL: PVC	INV. AT R 678.36m	CONNECTED
--------------------	--------------	---------------	-------------------	-----------

Cash Receipt No's:	WATER	SANITARY	STORM
--------------------	-------	----------	-------

CURB FROM PROPERTY LINE	5m	PAVEMENT WIDTH	10m
-------------------------	----	----------------	-----

HYDRO	75mm DB2	U/G CONNECTION	✓
-------	----------	----------------	---


TELEPHONE	100mm DB2	U/G CONNECTION	✓
-----------	-----------	----------------	---

GAS	42 PROP/P.E.
-----	--------------

Information Sheets: REF. DWGS. L&M ENGINEERING LTD. JOB. 1265-10 DWGS.

Comments:	CS CURB STOP CO CLEAN OUT	SDW WATER SERVICE STORM SERVICE SANITARY SERVICE	HTC HYDRO SERVICE CABLE SERVICE TELECOMMUNICATIONS	GAS GAS E ELECTRICAL
-----------	------------------------------	--	--	-------------------------

**THE INFORMATION CONTAINED HEREIN IS FOR INTERNAL USE ONLY.
NOT TO BE RELIED UPON UNLESS CONFIRMED BY THE SITE INSPECTION AND/OR INVESTIGATION**

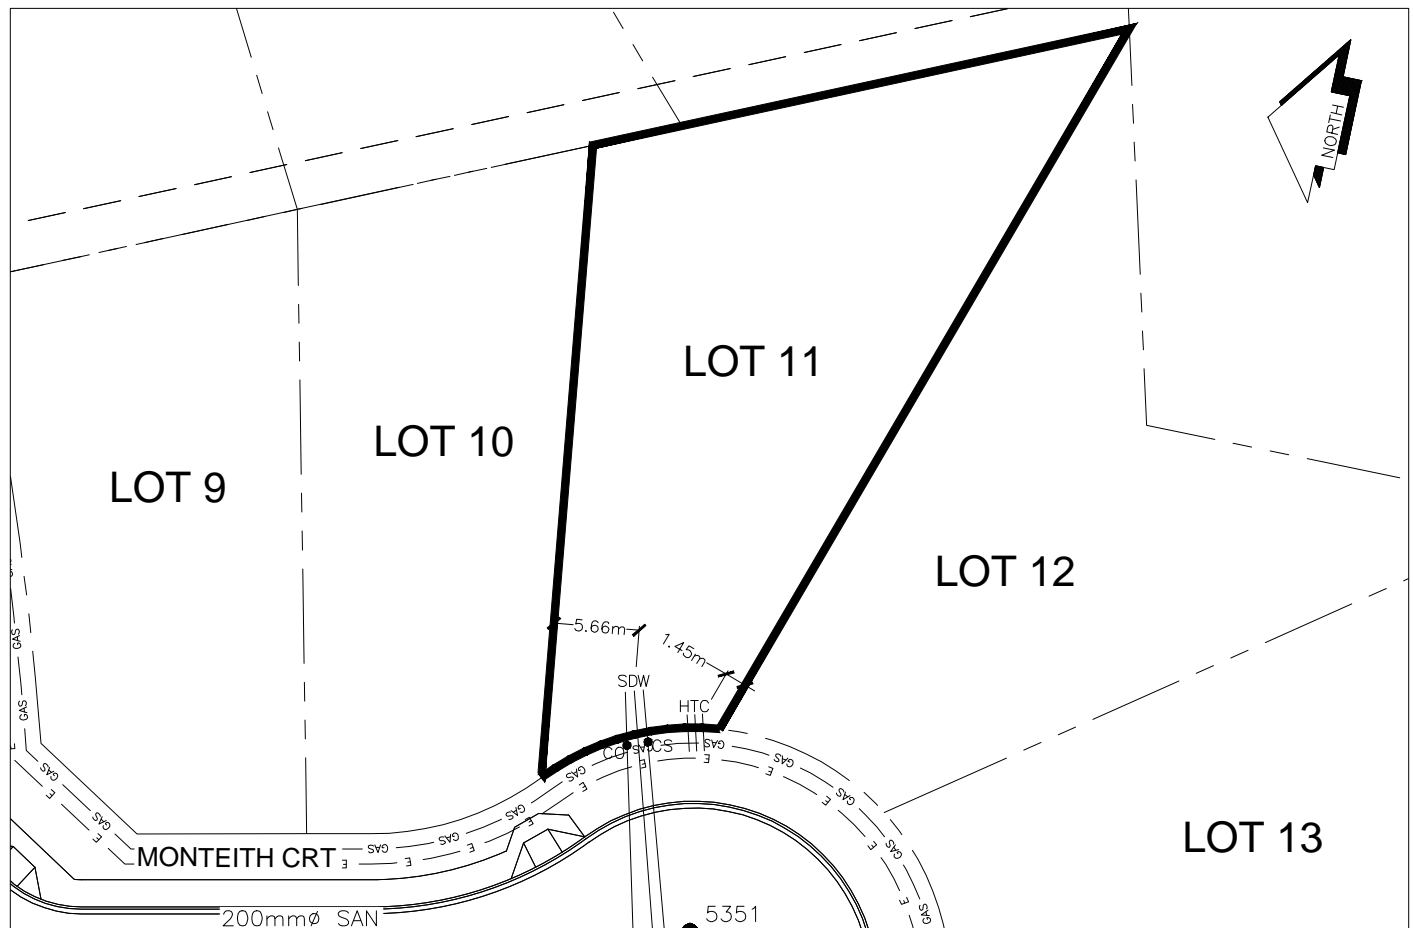

SANITARY, STORM & WATER SERVICE INVERTS	SANITARY	WATER	STORM
1. Distance from San. M.H. <u>5351</u> toward San. M.H. <u>5350</u> to lot service connection point is:	4.00m	N/A	N/A
1a.Distance from Stm. M.H. <u>3934</u> toward Stm. M.H. <u>3935</u> to lot service connection point is:	N/A	N/A	3.20m
2. Main Size at connection point is	200mmØ	200mmØ	250mmØ
3. Invert of service at main conn. stub point is	677.25m	677.27m	677.79m
4. Invert at service end is	678.38m	678.52m	678.44m
5. Cover at property line in meters	2.60m	2.76m	2.59m
6. Survey Date:AUG 2014 Book Ref.:1265-10 By:SHARP CONSTRUCTION			

SANITARY HISTORY:

DATE INSTALLED: AUG 2014

INSTALLED BY: SHARP CONSTRUCTION

WATER HISTORY:

DATE INSTALLED: AUG 2014

INSTALLED BY: SHARP CONSTRUCTION

STORM HISTORY:

DATE INSTALLED: AUG 2014

INSTALLED BY: SHARP CONSTRUCTION