

# City of Prince George

## HISTORY SHEET

PID: 029-852-145

Scale: 1:500

Legal: LOT 18

D.L.: 2003

PLAN: EPP52840

Address: 1112 MONTEITH CRT

|                       |              |               |                   |           |
|-----------------------|--------------|---------------|-------------------|-----------|
| Sanitary Connection:# | SIZE: 100mmØ | MATERIAL: PVC | INV. AT R 679.20m | CONNECTED |
|-----------------------|--------------|---------------|-------------------|-----------|

|                    |             |                  |                   |           |
|--------------------|-------------|------------------|-------------------|-----------|
| Water Connection:# | SIZE: 19mmØ | MATERIAL: COPPER | INV. AT R 679.18m | CONNECTED |
|--------------------|-------------|------------------|-------------------|-----------|

|                    |              |               |                   |           |
|--------------------|--------------|---------------|-------------------|-----------|
| Storm Connection:# | SIZE: 100mmØ | MATERIAL: PVC | INV. AT R 679.21m | CONNECTED |
|--------------------|--------------|---------------|-------------------|-----------|

|                    |       |          |       |
|--------------------|-------|----------|-------|
| Cash Receipt No's: | WATER | SANITARY | STORM |
|--------------------|-------|----------|-------|

|                         |    |                |     |
|-------------------------|----|----------------|-----|
| CURB FROM PROPERTY LINE | 5m | PAVEMENT WIDTH | 10m |
|-------------------------|----|----------------|-----|

|       |          |                |   |
|-------|----------|----------------|---|
| HYDRO | 75mm DB2 | U/G CONNECTION | ✓ |
|-------|----------|----------------|---|


|           |           |                |   |
|-----------|-----------|----------------|---|
| TELEPHONE | 100mm DB2 | U/G CONNECTION | ✓ |
|-----------|-----------|----------------|---|

|     |              |  |  |
|-----|--------------|--|--|
| GAS | 42 PROP/P.E. |  |  |
|-----|--------------|--|--|

Information Sheets: REF. DWGS. L&M ENGINEERING LTD. JOB. 1265-10 DWGS.

Comments: CS CURB STOP CO CLEAN OUT SDW WATER SERVICE STORM SERVICE SANITARY SERVICE SDW HYDRO SERVICE CABLE SERVICE TELECOMMUNICATIONS GAS GAS E ELECTRICAL

THE INFORMATION CONTAINED HEREIN IS FOR INTERNAL USE ONLY.  
NOT TO BE RELIED UPON UNLESS CONFIRMED BY THE SITE INSPECTION AND/OR INVESTIGATION

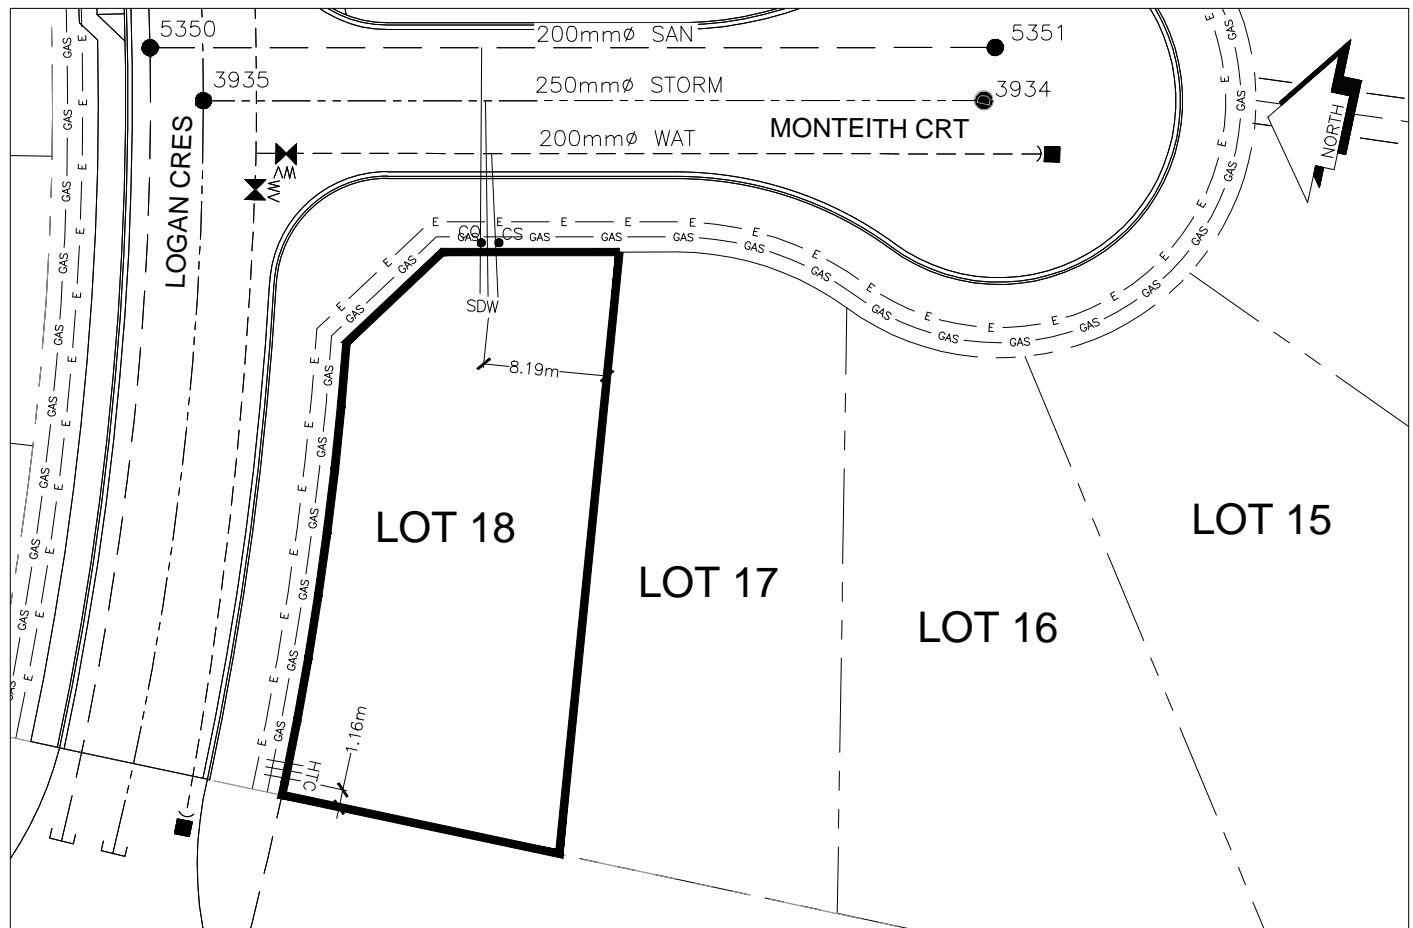

| SANITARY, STORM & WATER SERVICE INVERTS   | SANITARY | WATER   | STORM   |
|---|----------|---------|---------|
| 1. Distance from San. M.H. <u>5350</u> toward San. M.H. <u>5351</u> to lot service connection point is: | 21.90m   | N/A     | N/A     |
| 1a.Distance from Stm. M.H. <u>3935</u> toward Stm. M.H. <u>3934</u> to lot service connection point is: | N/A      | N/A     | 18.70m  |
| 2. Main Size at connection point is   | 200mmØ   | 200mmØ  | 250mmØ  |
| 3. Invert of service at main conn. stub point is  | 677.13m  | 678.14m | 677.65m |
| 4. Invert at service end is   | 679.29m  | 679.25m | 679.31m |
| 5. Cover at property line in meters   | 2.34m    | 2.44m   | 2.35m   |
| 6. Survey Date:AUG 2014    Book Ref.:1265-10    By:SHARP CONSTRUCTION                                   |          |         |         |
|   |          |         |         |
|   |          |         |         |
SANITARY HISTORY:

DATE INSTALLED: AUG 2014

INSTALLED BY: SHARP CONSTRUCTION

WATER HISTORY:

DATE INSTALLED: AUG 2014

INSTALLED BY: SHARP CONSTRUCTION

STORM HISTORY:

DATE INSTALLED: AUG 2014

INSTALLED BY: SHARP CONSTRUCTION