

City of Prince George

HISTORY SHEET

PID: 029-852-161

Scale: 1:500

Legal: LOT 23

D.L.: 2003

PLAN: EPP52840

Address: 4848 LOGAN CRES

| | | | | |
|-----------------------|--------------|---------------|-------------------|-----------|
| Sanitary Connection:# | SIZE: 100mmØ | MATERIAL: PVC | INV. AT R 677.61m | CONNECTED |
|-----------------------|--------------|---------------|-------------------|-----------|

| | | | | |
|--------------------|-------------|------------------|-------------------|-----------|
| Water Connection:# | SIZE: 19mmØ | MATERIAL: COPPER | INV. AT R 677.62m | CONNECTED |
|--------------------|-------------|------------------|-------------------|-----------|

| | | | | |
|--------------------|--------------|---------------|-------------------|-----------|
| Storm Connection:# | SIZE: 100mmØ | MATERIAL: PVC | INV. AT R 677.61m | CONNECTED |
|--------------------|--------------|---------------|-------------------|-----------|

| | | | |
|--------------------|-------|----------|-------|
| Cash Receipt No's: | WATER | SANITARY | STORM |
|--------------------|-------|----------|-------|

| | | | |
|-------------------------|----|----------------|-----|
| CURB FROM PROPERTY LINE | 5m | PAVEMENT WIDTH | 10m |
|-------------------------|----|----------------|-----|

| | | | |
|-------|----------|----------------|---|
| HYDRO | 75mm DB2 | U/G CONNECTION | ✓ |
|-------|----------|----------------|---|


| | | | |
|-----------|-----------|----------------|---|
| TELEPHONE | 100mm DB2 | U/G CONNECTION | ✓ |
|-----------|-----------|----------------|---|

| | | | |
|-----|--------------|--|--|
| GAS | 42 PROP/P.E. | | |
|-----|--------------|--|--|

Information Sheets: REF. DWGS. L&M ENGINEERING LTD. JOB. 1265-10 DWGS.

Comments: CS CURB STOP CO CLEAN OUT WDS WATER SERVICE SOW STORM SERVICE SANITARY SERVICE HYDRO SERVICE CABLE SERVICE TELECOMMUNICATIONS GAS GAS E ELECTRICAL

THE INFORMATION CONTAINED HEREIN IS FOR INTERNAL USE ONLY.
NOT TO BE RELIED UPON UNLESS CONFIRMED BY THE SITE INSPECTION AND/OR INVESTIGATION

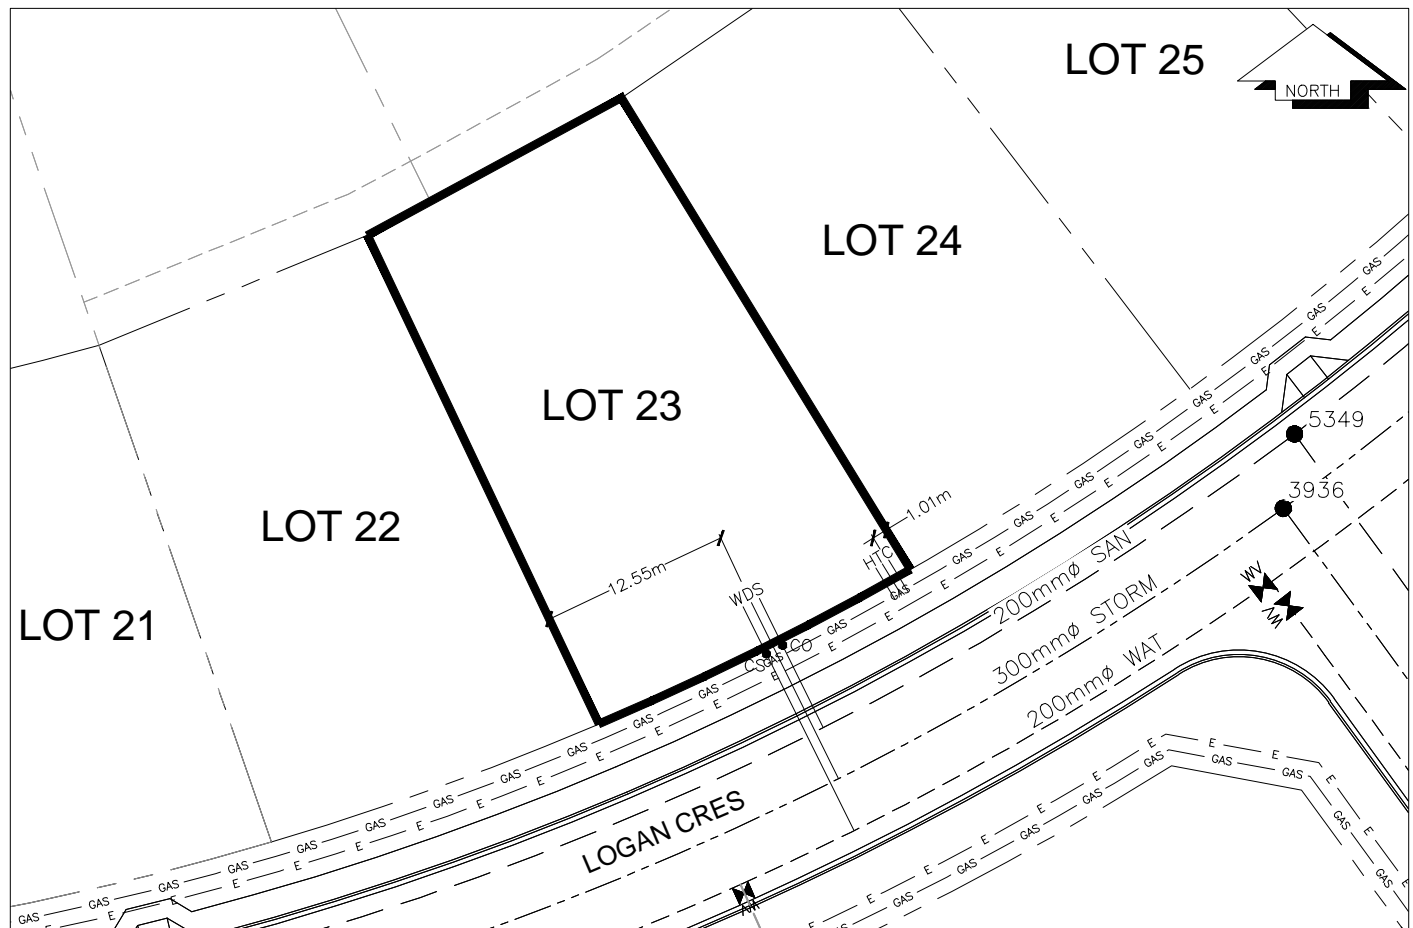

| SANITARY, STORM & WATER SERVICE INVERTS | SANITARY | WATER | STORM |
|---|----------|---------|---------|
| 1. Distance from San. M.H. <u>5349</u> toward San. M.H. <u>5350</u> to lot service connection point is: | 36.70m | N/A | N/A |
| 1a.Distance from Stm. M.H. <u>3936</u> toward Stm. M.H. <u>3935</u> to lot service connection point is: | N/A | N/A | 34.20m |
| 2. Main Size at connection point is | 200mmØ | 200mmØ | 300mmØ |
| 3. Invert of service at main conn. stub point is | 676.24m | 677.18m | 676.06m |
| 4. Invert at service end is | 677.82m | 677.72m | 677.82m |
| 5. Cover at property line in meters | 2.56m | 2.63m | 2.56m |
| 6. Survey Date:AUG 2014 Book Ref.:1265-10 By:SHARP CONSTRUCTION | | | |
| | | | |
| | | | |
SANITARY HISTORY:

DATE INSTALLED: AUG 2014

INSTALLED BY: SHARP CONSTRUCTION

WATER HISTORY:

DATE INSTALLED: AUG 2014

INSTALLED BY: SHARP CONSTRUCTION

STORM HISTORY:

DATE INSTALLED: AUG 2014

INSTALLED BY: SHARP CONSTRUCTION