

City of Prince George

HISTORY SHEET

PID: 029-852-188

Scale: 1:500

Legal: LOT 25

D.L.: 2003

PLAN: EPP52840

Address: 4832 LOGAN CRES

Sanitary Connection:#	SIZE: 100mmØ	MATERIAL: PVC	INV. AT R 676.96m	CONNECTED
-----------------------	--------------	---------------	-------------------	-----------

Water Connection:#	SIZE: 19mmØ	MATERIAL: COPPER	INV. AT R 676.95m	CONNECTED
--------------------	-------------	------------------	-------------------	-----------

Storm Connection:#	SIZE: 100mmØ	MATERIAL: PVC	INV. AT R 676.96m	CONNECTED
--------------------	--------------	---------------	-------------------	-----------

Cash Receipt No's:	WATER	SANITARY	STORM
--------------------	-------	----------	-------

CURB FROM PROPERTY LINE	5m	PAVEMENT WIDTH	10m
-------------------------	----	----------------	-----

HYDRO	75mm DB2	U/G CONNECTION	✓
-------	----------	----------------	---


TELEPHONE	100mm DB2	U/G CONNECTION	✓
-----------	-----------	----------------	---

GAS	42 PROP/P.E.		
-----	--------------	--	--

Information Sheets: REF. DWGS. L&M ENGINEERING LTD. JOB. 1265-10 DWGS.

Comments: CS CURB STOP CO CLEAN OUT WDS WATER SERVICE SOW STORM SERVICE SDW SANITARY SERVICE HTC HYDRO SERVICE CTS CABLE SERVICE TCS TELECOMMUNICATIONS GAS GAS E ELECTRICAL

THE INFORMATION CONTAINED HEREIN IS FOR INTERNAL USE ONLY.
NOT TO BE RELIED UPON UNLESS CONFIRMED BY THE SITE INSPECTION AND/OR INVESTIGATION

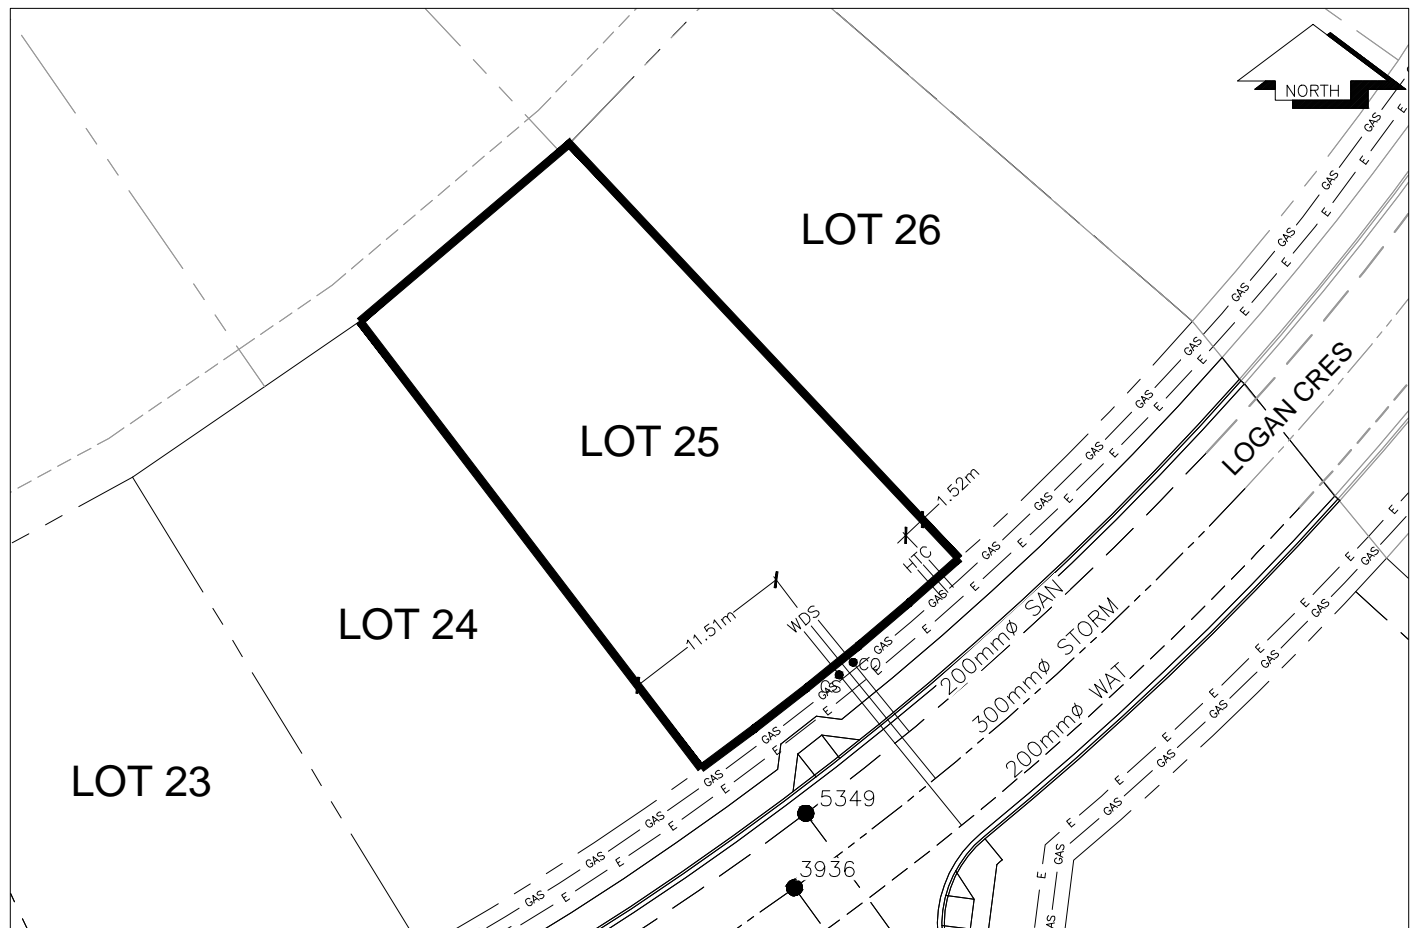

SANITARY, STORM & WATER SERVICE INVERTS	SANITARY	WATER	STORM
1. Distance from San. M.H. <u>5349</u> toward San. M.H. <u>5011</u> to lot service connection point is:	9.00m	N/A	N/A
1a.Distance from Stm. M.H. <u>3936</u> toward Stm. M.H. <u>3510</u> to lot service connection point is:	N/A	N/A	12.00m
2. Main Size at connection point is	200mmØ	200mmØ	300mmØ
3. Invert of service at main conn. stub point is	675.61m	676.51m	675.02m
4. Invert at service end is	677.05m	677.02m	677.06m
5. Cover at property line in meters	2.62m	2.75m	2.63m
6. Survey Date:AUG 2014 Book Ref.:1265-10 By:SHARP CONSTRUCTION			

SANITARY HISTORY:

DATE INSTALLED: AUG 2014

INSTALLED BY: SHARP CONSTRUCTION

WATER HISTORY:

DATE INSTALLED: AUG 2014

INSTALLED BY: SHARP CONSTRUCTION

STORM HISTORY:

DATE INSTALLED: AUG 2014

INSTALLED BY: SHARP CONSTRUCTION