

# City of Prince George

## HISTORY SHEET

PID: 029-852-200

Scale: 1:500

Legal: LOT 19

D.L.: 2003

PLAN: EPP52840

Address: 4880 LOGAN CRES

Sanitary Connection:#	SIZE: 100mmØ	MATERIAL: PVC	INV. AT R 681.35m	CONNECTED
-----------------------	--------------	---------------	-------------------	-----------

Water Connection:#	SIZE: 19mmØ	MATERIAL: COPPER	INV. AT R 681.42m	CONNECTED
--------------------	-------------	------------------	-------------------	-----------

Storm Connection:#	SIZE: 100mmØ	MATERIAL: PVC	INV. AT R 681.38m	CONNECTED
--------------------	--------------	---------------	-------------------	-----------

Cash Receipt No's:	WATER	SANITARY	STORM
--------------------	-------	----------	-------

CURB FROM PROPERTY LINE	5m	PAVEMENT WIDTH	10m
-------------------------	----	----------------	-----

HYDRO	75mm DB2	U/G CONNECTION	✓
-------	----------	----------------	---

TELEPHONE	100mm DB2	U/G CONNECTION	✓
-----------	-----------	----------------	---


GAS	42 PROP/P.E.
-----	--------------

Information Sheets: REF. DWGS. L&M ENGINEERING LTD. JOB. 1265-10 DWGS.

Comments:

CS CURB STOP CO CLEAN OUT	WDS WATER SERVICE SOW STORM SERVICE SOW SANITARY SERVICE	H HYDRO SERVICE C CABLE SERVICE T TELECOMMUNICATIONS	GAS GAS E ELECTRICAL
------------------------------	--	--	-------------------------

THE INFORMATION CONTAINED HEREIN IS FOR INTERNAL USE ONLY.  
NOT TO BE RELIED UPON UNLESS CONFIRMED BY THE SITE INSPECTION AND/OR INVESTIGATION

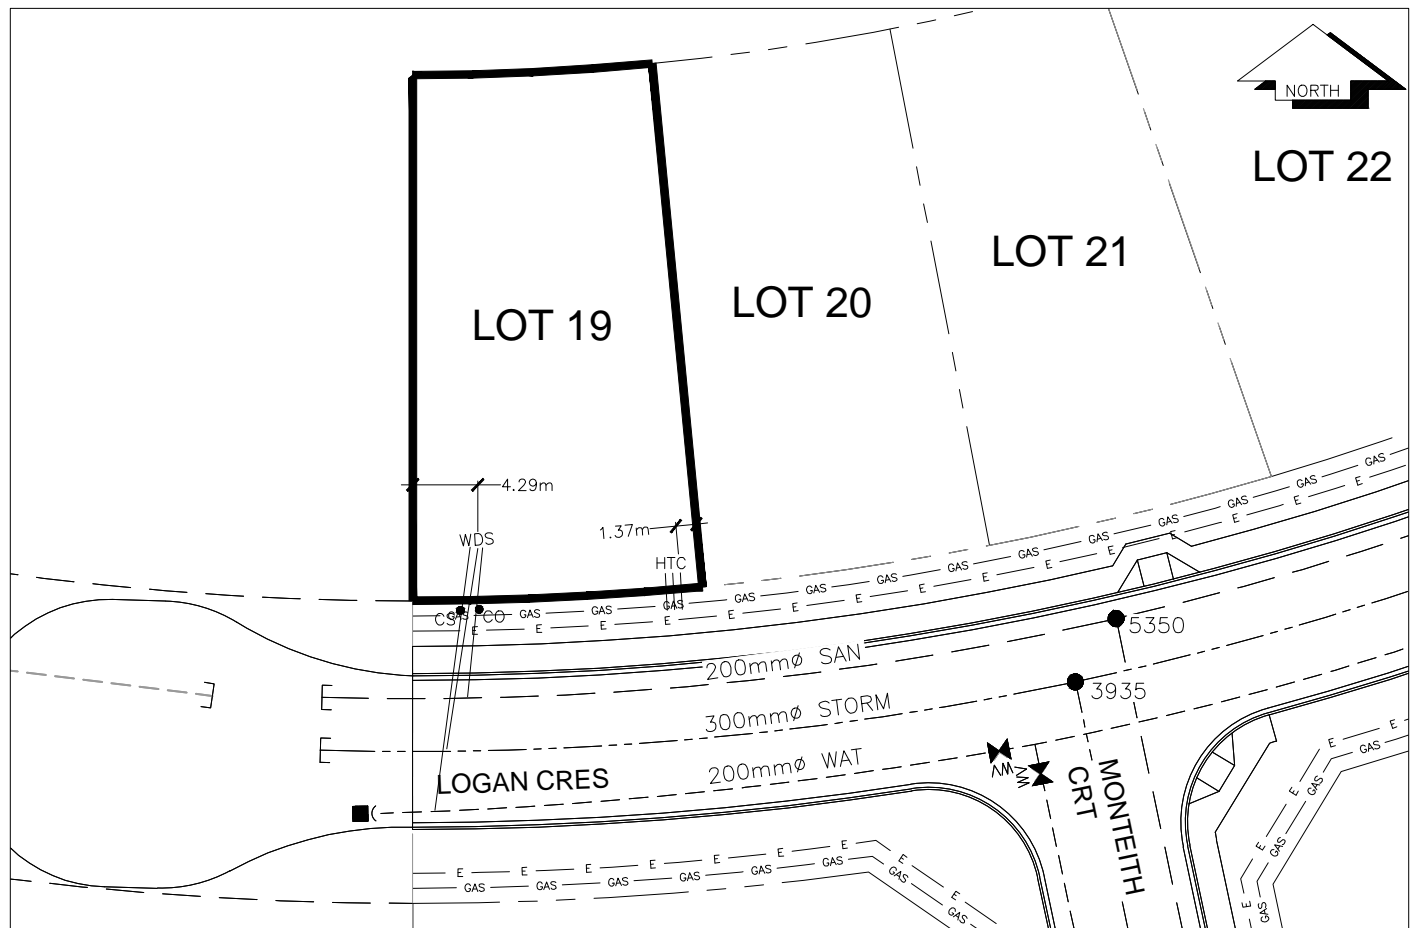

SANITARY, STORM & WATER SERVICE INVERTS	SANITARY	WATER	STORM
1. Distance from San. M.H. <u>5350</u> toward San. M.H. <u>STUB</u> to lot service connection point is:	43.50m	N/A	N/A
1a.Distance from Stm. M.H. <u>3935</u> toward Stm. M.H. <u>STUB</u> to lot service connection point is:	N/A	N/A	42.00m
2. Main Size at connection point is	200mmØ	200mmØ	300mmØ
3. Invert of service at main conn. stub point is	679.70	680.59m	679.65m
4. Invert at service end is	681.44m	681.49m	681.52m
5. Cover at property line in meters	2.59m	2.60m	2.59m
6. Survey Date:AUG 2014    Book Ref.:1265-10    By:SHARP CONSTRUCTION			

SANITARY HISTORY:

DATE INSTALLED: AUG 2014

INSTALLED BY: SHARP CONSTRUCTION

WATER HISTORY:

DATE INSTALLED: AUG 2014

INSTALLED BY: SHARP CONSTRUCTION

STORM HISTORY:

DATE INSTALLED: AUG 2014

INSTALLED BY: SHARP CONSTRUCTION