

City of Prince George

HISTORY SHEET

PID: 029-852-226

Scale: 1:500

Legal: LOT 21

D.L.: 2003

PLAN: EPP52840


Address: 4864 LOGAN CRES

Sanitary Connection:#	SIZE: 100mmØ	MATERIAL: PVC	INV. AT R 678.88m	CONNECTED
Water Connection:#	SIZE: 19mmØ	MATERIAL: COPPER	INV. AT R 678.92m	CONNECTED
Storm Connection:#	SIZE: 100mmØ	MATERIAL: PVC	INV. AT R 678.88m	CONNECTED
Cash Receipt No's:	WATER	SANITARY	STORM	
CURB FROM PROPERTY LINE	5m	PAVEMENT WIDTH	10m	
HYDRO	75mm DB2	U/G CONNECTION	✓	
TELEPHONE	100mm DB2	U/G CONNECTION	✓	
GAS	42 PROP/P.E.			

Information Sheets: REF. DWGS. L&M ENGINEERING LTD. JOB. 1265-10 DWGS.

Comments: CS CURB STOP CO CLEAN OUT WDS WATER SERVICE SDC STORM SERVICE MGS SANITARY SERVICE HTC HYDRO SERVICE CABLE SERVICE TELECOMMUNICATIONS GAS GAS E ELECTRICAL

THE INFORMATION CONTAINED HEREIN IS FOR INTERNAL USE ONLY.
NOT TO BE RELIED UPON UNLESS CONFIRMED BY THE SITE INSPECTION AND/OR INVESTIGATION

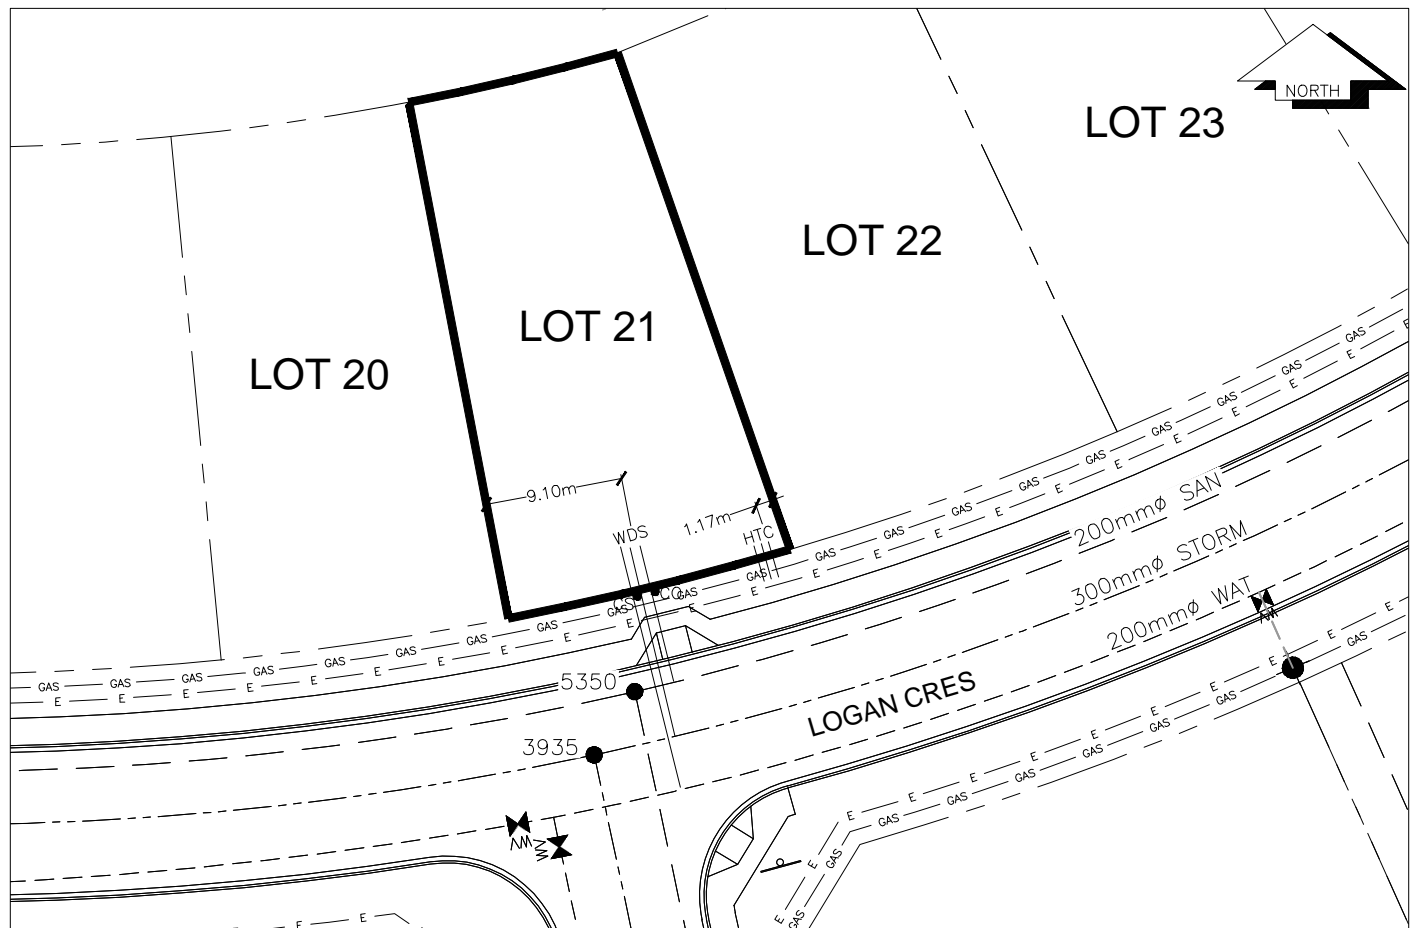

SANITARY, STORM & WATER SERVICE INVERTS	SANITARY	WATER	STORM
1. Distance from San. M.H. <u>5350</u> toward San. M.H. <u>5349</u> to lot service connection point is:	3.00m	N/A	N/A
1a.Distance from Stm. M.H. <u>3935</u> toward Stm. M.H. <u>3936</u> to lot service connection point is:	N/A	N/A	6.00m
2. Main Size at connection point is	200mmØ	200mmØ	300mmØ
3. Invert of service at main conn. stub point is	676.92m	678.36m	677.35m
4. Invert at service end is	679.04m	678.90m	678.94m
5. Cover at property line in meters	2.77m	2.81m	2.77m
6. Survey Date:AUG 2014 Book Ref.:1265-10 By:SHARP CONSTRUCTION			

SANITARY HISTORY:

DATE INSTALLED: AUG 2014

INSTALLED BY: SHARP CONSTRUCTION

WATER HISTORY:

DATE INSTALLED: AUG 2014

INSTALLED BY: SHARP CONSTRUCTION

STORM HISTORY:

DATE INSTALLED: AUG 2014

INSTALLED BY: SHARP CONSTRUCTION