



# City of Prince George History Sheet

PID:	029856094
MU:	101724
WO:	87871

Civic Address: 4509 Zral Road

Legal Description: Lot: 1 District Lot: 2425 Plan: EPP60830


Service Type	Diameter (mm)	Material	Invert Elev at main (m)	Invert Elev at property line (m)	Invert Elev at service end (m)	Distance into property (m)	Installation Date
Sanitary	100mm	PVC	-	-	-	-	Oct 2016
Water	20mm	Copper	-	-	-	-	Oct 2016
Storm	N/A	N/A	-	-	-	-	

Service Connection Location				Sanitary (m)	Storm (m)
Distance from downstream San MH	22	towards upstream San MH	21	37.1.	
Distance from downstream Stm MH	-	towards upstream Stm MH	-		

Power	Size	Communications	Size	Cable	Size	Gas	Size
BC Hydro	-	Telus	-	Shaw	-	FortisBC	-
Overhead Service		Overhead Service		Overhead Service			

Installed by:	City of Prince George forces	Survey Date:	-
Comments:	Water and Sanitary services of Kelly Rd N abandoned		

**NOT TO SCALE** The information contained herein is for internal use only.  
Not to be relied on unless confirmed by site inspection and/or investigation.

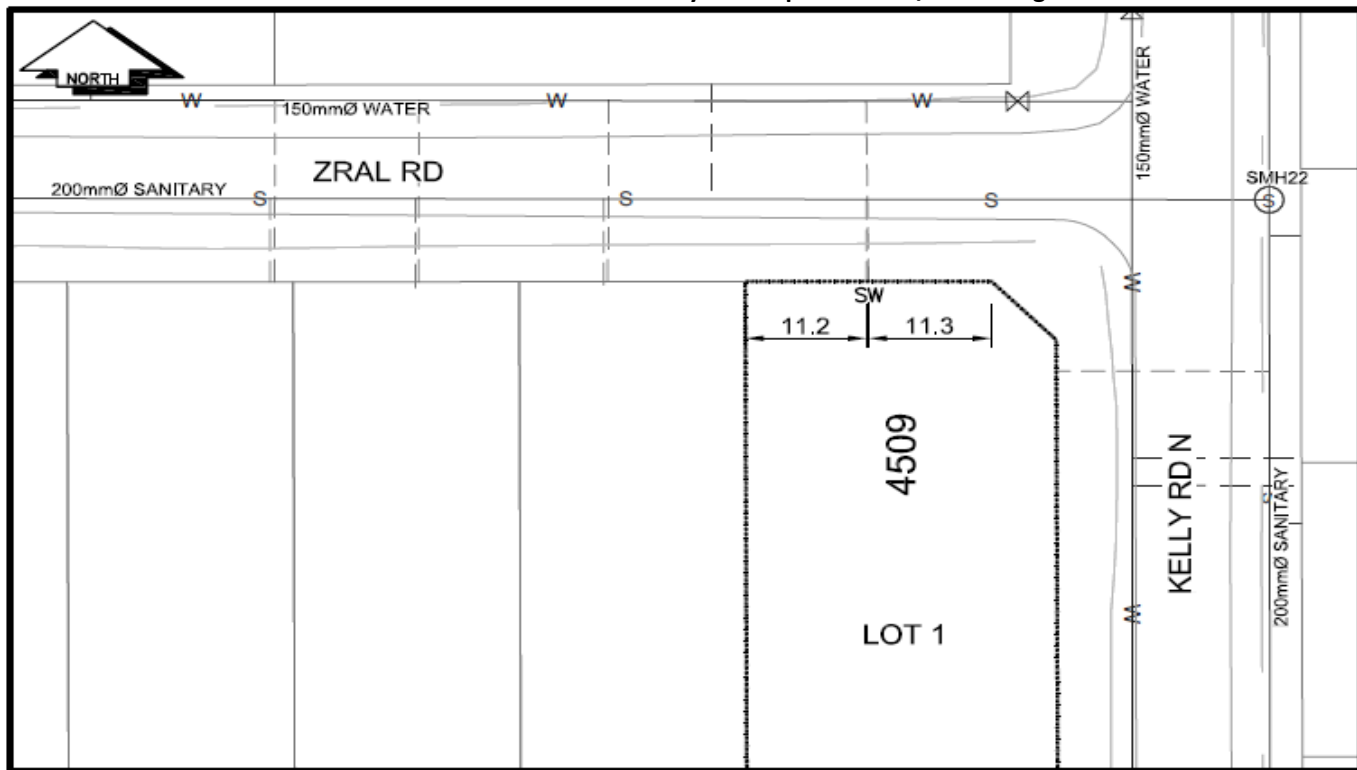

CS <sup>o</sup> CURB STOP	--- W WATER SERVICE	--- S STORM SERVICE
CO <sup>o</sup> CLEAN OUT	--- S SANITARY SERVICE	--- G GAS
WATER VALVE	--- F FIRE HYDRANT	--- E ENCUMBRANCE

**NOT TO SCALE**