



City of Prince George History Sheet

PID:	029867282
MU:	101367
WO:	69618/69619

Civic Address: 1649 Edmonton St

Legal Description: Lot: A District Lot: 343 Plan: EPP60907


Service Type	Diameter (mm)	Material	Invert Elev at main (m)	Invert Elev at property line (m)	Invert Elev at service end (m)	Distance into property (m)	Installation Date
Sanitary	100mm	PVC	-	-	-	-	June 2013
Water	20mm	Copper	-	-	-	-	June 2013
Storm	100mm	PVC	-	-	-	-	June 2013

Service Connection Location				Sanitary (m)	Storm (m)
Distance from downstream San MH	PW108	towards upstream San MH	881	107.90	
Storm service connected to Stm MH 2462					

Power	Size	Communications	Size	Cable	Size	Gas	Size
BC Hydro	-	Telus	-	Shaw	-	FortisBC	-
Overhead Service		Overhead Service		Overhead Service			

Installed by:	City of Prince George forces	Survey Date:	-
Comments:			

NOT TO SCALE The information contained herein is for internal use only.
Not to be relied on unless confirmed by site inspection and/or investigation.

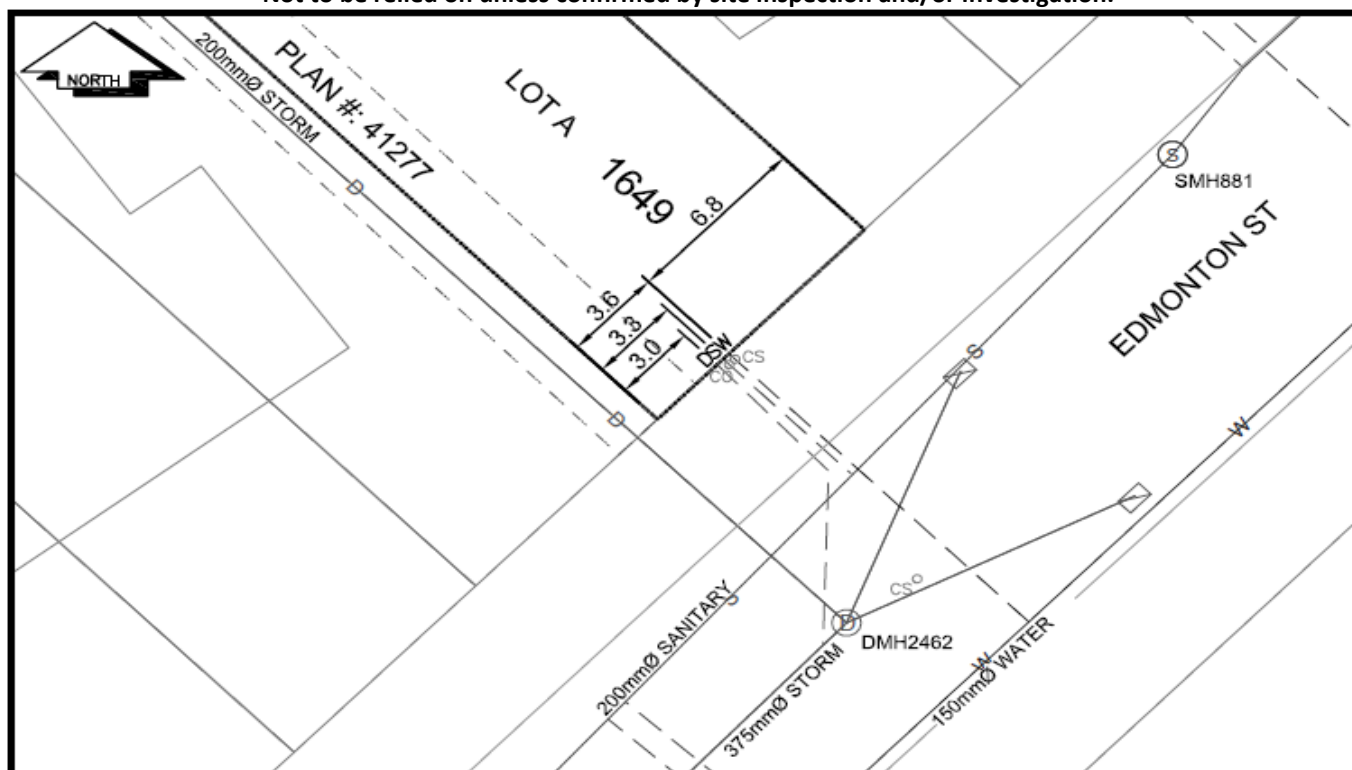

CS	CURB STOP	---	W	WATER SERVICE	---	D	STORM SERVICE
CO	CLEAN OUT	---	S	SANITARY SERVICE	---	G	GAS

NOT TO SCALE