



City of Prince George History Sheet

PID:	029912440
SD/MU:	
WO:	

Civic Address: 2150 Aintree Dr

Legal Description: Lot: 1 District Lot: 4377 Plan: EPP53964


Service Type	Diameter (mm)	Material	Invert Elev at main (m)	Invert Elev at property line (m)	Invert Elev at service end (m)	Distance into property (m)	Installation Date
Sanitary	100mm	Unknown	-	-	-	-	January 1978
Water	20mm	Copper	-	-	-	-	January 1972
Storm	N/A	N/A	-	-	-	-	

Service Connection Location					Sanitary (m)	Storm (m)
Distance from downstream San MH	1573	towards upstream San MH	1579		9.39	
Distance from downstream Stm MH	-	towards upstream Stm MH	-			

Power	Size	Communications	Size	Cable	Size	Gas	Size
BC Hydro	-	Telus	-	Shaw	-	FortisBC	-
Overhead Service		Overhead Service		Overhead Service			

Installed by:	Survey Date:	-
Comments:		

NOT TO SCALE The information contained herein is for internal use only.
Not to be relied on unless confirmed by site inspection and/or investigation.

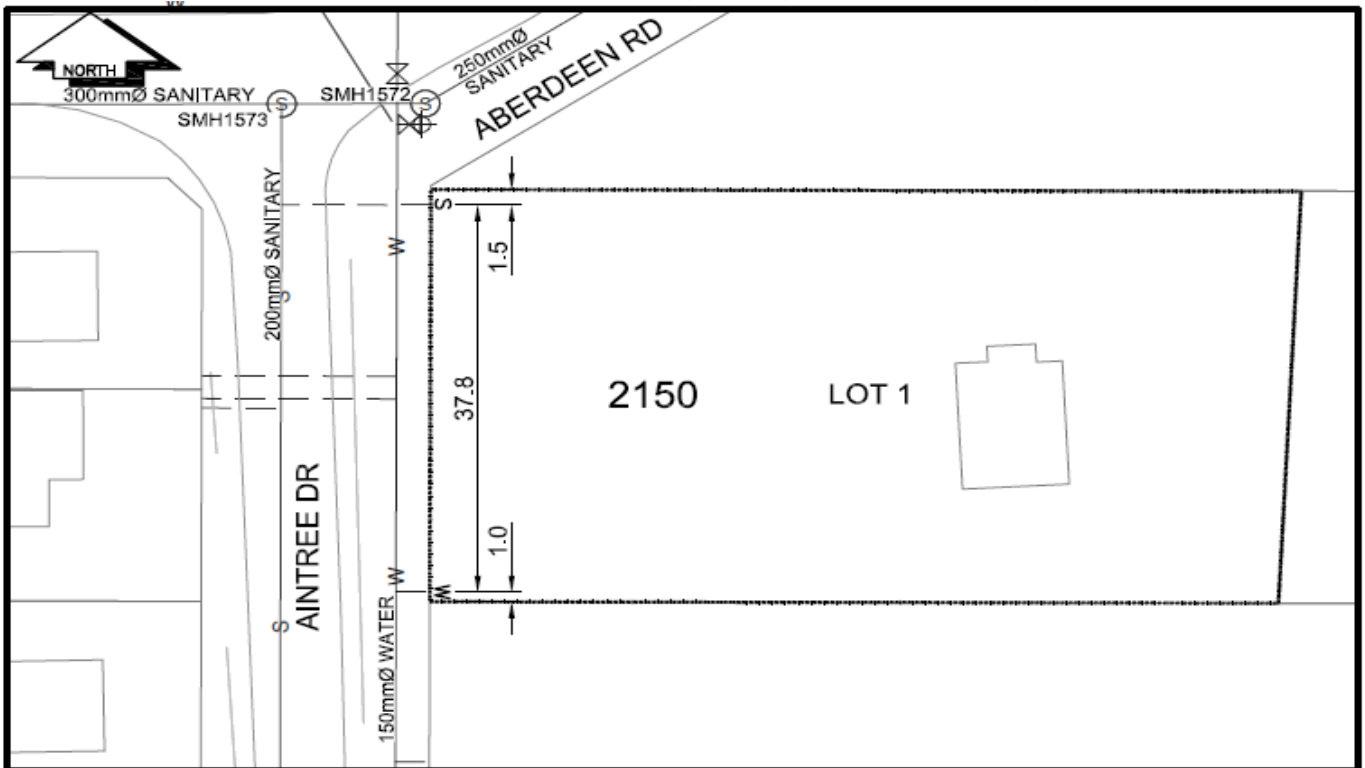

LEGEND:	CS ^o CURB STOP	---> WATER SERVICE	---> STORM SERVICE
	CO ^o CLEAN OUT	---S SANITARY SERVICE	---G GAS

NOT TO SCALE