



City of Prince George History Sheet

PID:	029912458
SD/MU:	
WO:	

Civic Address: 2155 Perth Rd

Legal Description: Lot: 2 District Lot: 4377 Plan: EPP53964


Service Type	Diameter (mm)	Material	Invert Elev at main (m)	Invert Elev at property line (m)	3.04	Distance into property (m)	Installation Date
Sanitary	100mm	Unknown	-	650.55	3.00	-	-
Water	20mm	Copper	-	-	-	-	-
Storm	N/A	N/A	-	-	-	-	-

Service Connection Location				Sanitary (m)	Storm (m)
Distance from downstream San MH	1547	towards upstream San MH	1580	81.33	
Distance from downstream Stm MH	-	towards upstream Stm MH	-		

Power	Size	Communications	Size	Cable	Size	Gas	Size
BC Hydro	-	Telus	-	Shaw	-	FortisBC	-
Overhead Service		Overhead Service		Overhead Service			

Installed by:	Survey Date:	-
Comments: Location as per old History Sheet - install date unknown		

NOT TO SCALE The information contained herein is for internal use only.
Not to be relied on unless confirmed by site inspection and/or investigation.

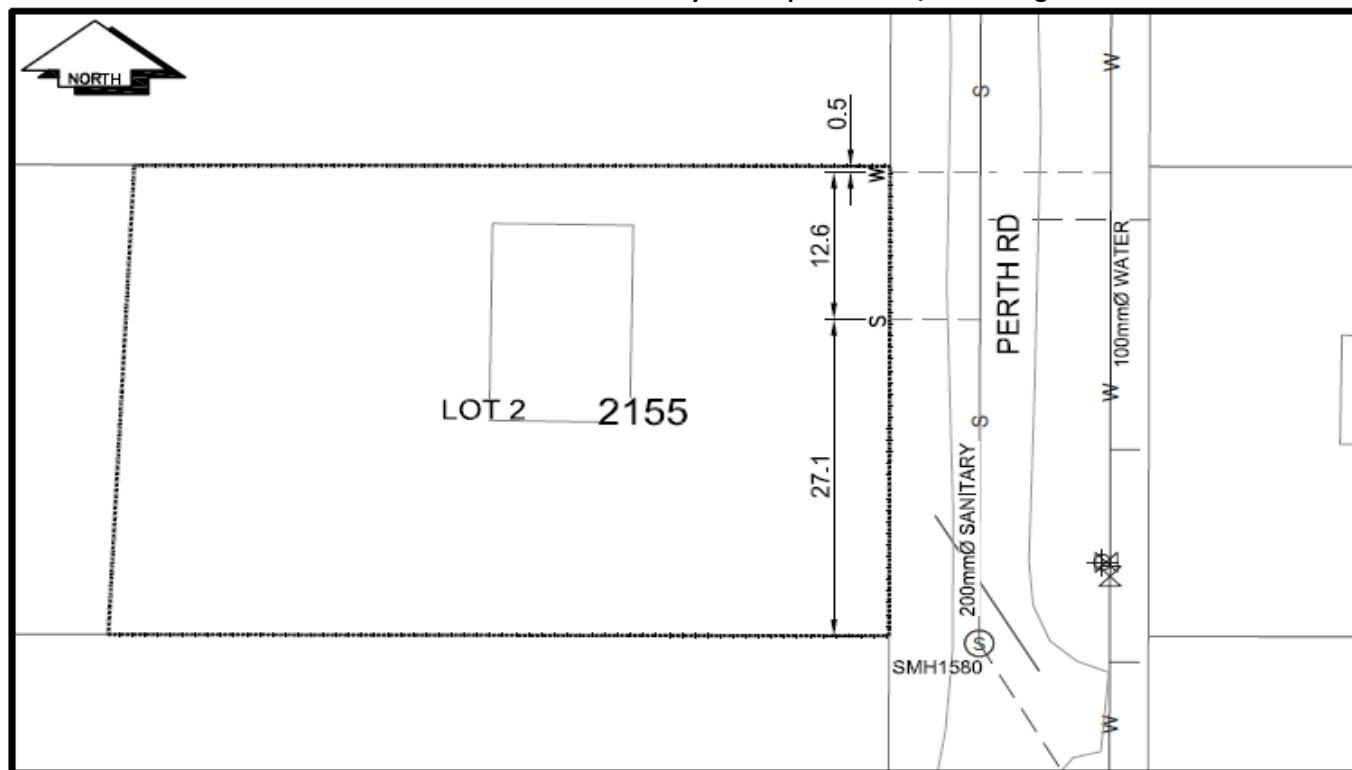

CS CURB STOP	---> WATER SERVICE	---> STORM SERVICE
CO CLEAN OUT	---S SANITARY SERVICE	---G GAS

NOT TO SCALE