

029914124



City of Prince George History Sheet

PID:	006723675
MU:	101682
WO:	85341

Civic Address: 4930 Banzer Drive

Legal Description: ~~Lot: 34 District Lot: 4039 Plan: 27213~~ Lot A, District Lot 4039, Cariboo District, Plan EPP54601


Service Type	Diameter (mm)	Material	Invert Elev at main (m)	Invert Elev at property line (m)	Invert Depth at service end (m)	Distance into property (m)	Installation Date
Sanitary	100mm	PVC	-	675.55	2.90	-	January 1980
Water	20mm	Copper	-	-	-	-	January 1980
Storm	200mm	PVC	-	675.00	-	-	October 2015

Service Connection Location				Sanitary (m)	Storm (m)
Distance from downstream San MH	1267	towards upstream San MH	1264	92.39	
200mm Storm service connection connected to Stm MH 2046					

Power	Size	Communications	Size	Cable	Size	Gas	Size
BC Hydro	-	Telus	-	Shaw	-	FortisBC	-
Overhead Service		Overhead Service		Overhead Service			

Installed by:	City of Prince George forces	Survey Date:	-
Comments:			

NOT TO SCALE The information contained herein is for internal use only.
Not to be relied on unless confirmed by site inspection and/or investigation.

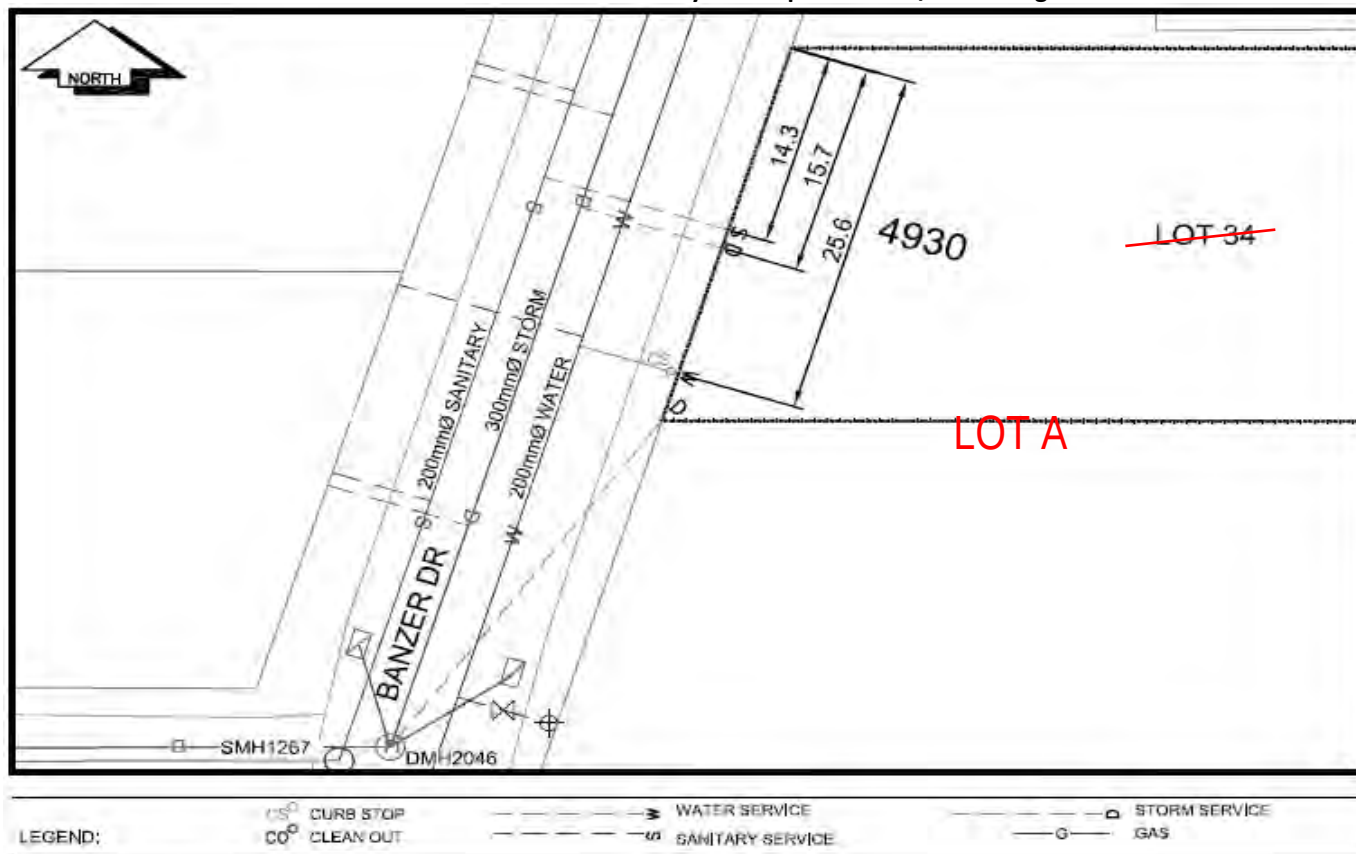

NOT TO SCALE