

# City of Prince George

## HISTORY SHEET

PID: 029-917-611

Scale: 1:500

Legal: LOT 2

D.L.: 2014

PLAN: EPP53901

Address: 7145 FOXRIDGE AVENUE

Sanitary Connection:#	SIZE: 100mmØ	MATERIAL: PVC	INV. AT RL 581.53m	CONNECTED
-----------------------	--------------	---------------	--------------------	-----------

Water Connection:#	SIZE: 19mmØ	MATERIAL: COPPER	INV. AT RL 581.59m	CONNECTED
--------------------	-------------	------------------	--------------------	-----------

Storm Connection:#	SIZE: 100mmØ	MATERIAL: PVC	INV. AT RL 581.53m	CONNECTED
--------------------	--------------	---------------	--------------------	-----------

Cash Receipt No's:	WATER	SANITARY	STORM
--------------------	-------	----------	-------

CURB FROM PROPERTY LINE	5m	PAVEMENT WIDTH	10m
-------------------------	----	----------------	-----

HYDRO	75mm DB2	U/G CONNECTION	✓
-------	----------	----------------	---

TELEPHONE	100mm DB2	U/G CONNECTION	✓
-----------	-----------	----------------	---


GAS	42 PROP/P.E.
-----	--------------

Information Sheets: REF. DWGS. L&M ENGINEERING LTD. JOB. 1282-11 DWGS.

Comments:

CS CURB STOP CO CLEAN OUT	SDW WATER SERVICE STW STORM SERVICE SAN SANITARY SERVICE	HCH HYDRO SERVICE CCH CABLE SERVICE TCH TELECOMMUNICATIONS	GAS GAS E ELECTRICAL
------------------------------	--	--	-------------------------

THE INFORMATION CONTAINED HEREIN IS FOR INTERNAL USE ONLY.  
NOT TO BE RELIED UPON UNLESS CONFIRMED BY THE SITE INSPECTION AND/OR INVESTIGATION

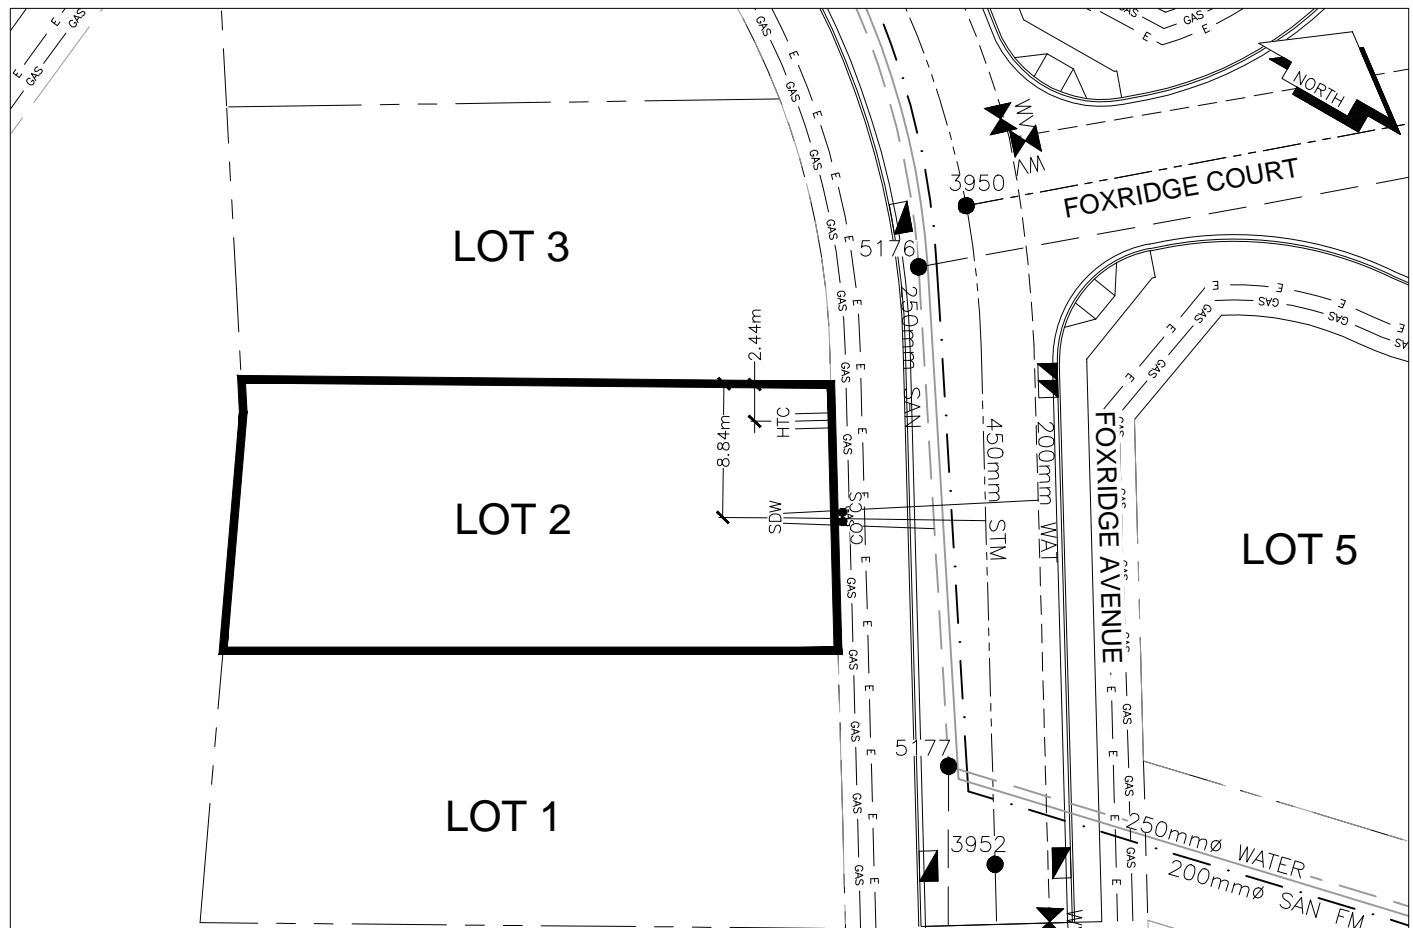

DATE INSTALLED: AUG 2015

INSTALLED BY: FORTWOOD HOMES LTD.

DATE INSTALLED: AUG 2015

INSTALLED BY: FORTWOOD HOMES LTD.

DATE INSTALLED: AUG 2015

INSTALLED BY: FORTWOOD HOMES LTD.