
## City of Prince George HISTORY SHEET

PID:	029-917-620	1				Scale	: 1:500			
Legal:	LOT 3					D.L.:	2014		PLAN: EPP53901	
Address	s: 7127 FOXRII	DGE AVENUE	<u> </u>							
Sanitary	/ Connection:#		SIZE:	100mmØ	MATERIAL:	PVC	INV. AT PL	581.78m	CONNECTED	
Water C	Connection:#		SIZE:	19mmØ	MATERIAL:	COPPER	INV. AT P	581.74m	CONNECTED	
Storm C	Connection:#		SIZE	100mmØ	MATERIAL	PVC	INV. AT PL	581.76m	CONNECTED	
Cash Re	eceipt No's:			WATER		SANITARY		S	TORM	
CURB F	ROM PROPER	TY LINE	5m				P.	AVEMENT V	VIDTH 10m	
HYDRO	)	75mm DB2				U/G CONNECTIO	ON ~	/		
TELEPH	HONE	100mm DB2	2			U/G CONNECTIO	ON ~			
GAS		42 PROP/P	E.							
Informa	tion Sheets:	F	EF. DWGS		ERING LTD. JOB					
Comme	nts:	CS CL	RB STOP EAN OUT		WATER SERVICI STORM SERVICI SANITARY SERV	ICE =	HYDRO SEF CABLE SER TELECOMM	RVICE VICE IUNICASTION	— GAS — GAS S — E — ELECTRI	CAL

## THE INFORMATION CONTAINED HEREIN IS FOR INTERNAL USE ONLY. NOT TO BE RELIED UPON UNLESS CONFIRMED BY THE SITE INSPECTION AND/OR INVESTIGATION

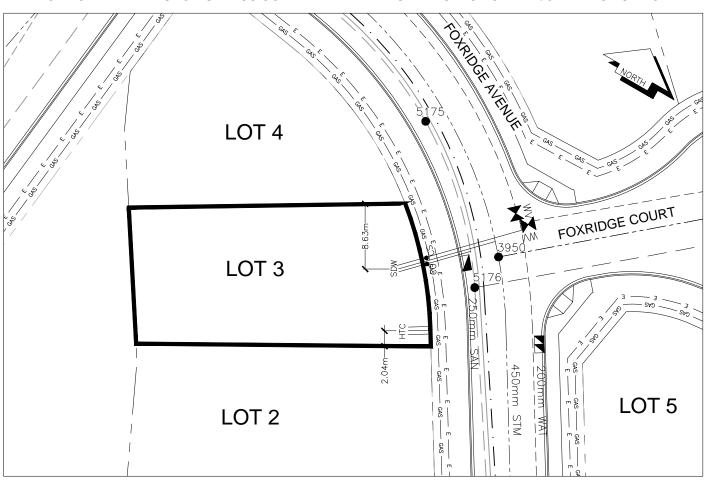

SANITARY, STORM & WATER SERVICE INVERTS	SANITARY	WATER	STORM
1. Distance from San. M.H. <u>5176</u> toward San. M.H. <u>5175</u> to lot service connection point is:	4.79m	N/A	N/A
1a.Distance from Stm. M.H. 3950 toward Stm. M.H. 3949 to lot service connection point is:	N/A	N/A	2.14m
2. Main Size at connection point is	200mmØ	200mmØ	450mmØ
3. Invert of service at main conn. stub point is	581.56m	580.88m	580.94m
4. Invert at service end is	581.85m	581.80m	581.87m
5. Cover at property line in meters	2.39m	2.43m	2.41m
6. Survey Date: AUG 2015 Book Ref.:1140-13 By: FORTWOOD HOMES LTD.			
SANITARY HISTORY:			
DATE INSTALLED: AUG 2015			
INSTALLED BY: FORTWOOD HOMES LTD.			
WATER HISTORY:			
DATE INSTALLED: AUG 2015			
INSTALLED BY: FORTWOOD HOMES LTD.			
STORM HISTORY:			
DATE INSTALLED: AUG 2015			
INSTALLED BY: FORTWOOD HOMES LTD.			