

City of Prince George

HISTORY SHEET

PID: 029-917-654

Scale: 1:500

Legal: LOT 6

D.L.: 2014

PLAN: EPP53901

Address: 7150 FOXRIDGE COURT

Sanitary Connection:#	SIZE: 100mmØ	MATERIAL: PVC	INV. AT R 582.50m	CONNECTED
-----------------------	--------------	---------------	-------------------	-----------

Water Connection:#	SIZE: 19mmØ	MATERIAL: COPPER	INV. AT R 582.28m	CONNECTED
--------------------	-------------	------------------	-------------------	-----------

Storm Connection:#	SIZE: 100mmØ	MATERIAL: PVC	INV. AT R 582.50m	CONNECTED
--------------------	--------------	---------------	-------------------	-----------

Cash Receipt No's:	WATER	SANITARY	STORM
--------------------	-------	----------	-------

CURB FROM PROPERTY LINE	5m	PAVEMENT WIDTH	10m
-------------------------	----	----------------	-----

HYDRO	75mm DB2	U/G CONNECTION	✓
-------	----------	----------------	---

TELEPHONE	100mm DB2	U/G CONNECTION	✓
-----------	-----------	----------------	---


GAS	42 PROP/P.E.
-----	--------------

Information Sheets: REF. DWGS. L&M ENGINEERING LTD. JOB. 1282-11 DWGS.

Comments:

CS CURB STOP	SDW WATER SERVICE	TH HYDRO SERVICE	GAS GAS
CO CLEAN OUT	SDW STORM SERVICE	TH CABLE SERVICE	E ELECTRICAL
	SDW SANITARY SERVICE	TH TELECOMMUNICATIONS	

**THE INFORMATION CONTAINED HEREIN IS FOR INTERNAL USE ONLY.
NOT TO BE RELIED UPON UNLESS CONFIRMED BY THE SITE INSPECTION AND/OR INVESTIGATION**

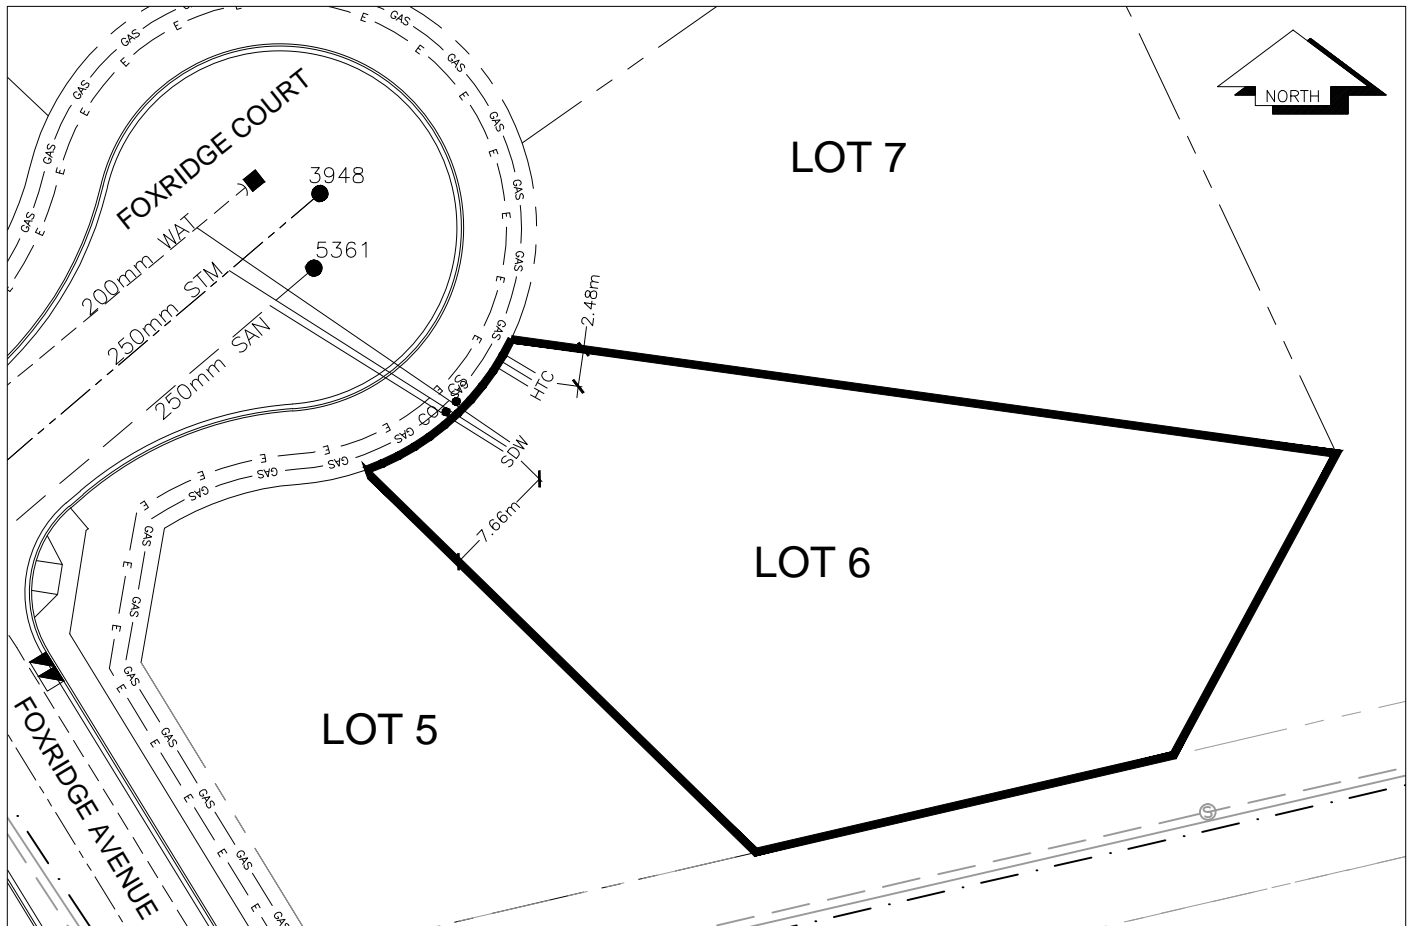

SANITARY, STORM & WATER SERVICE INVERTS	SANITARY	WATER	STORM
1. Distance from San. M.H. <u>5361</u> toward San. M.H. <u>5176</u> to lot service connection point is:	3.94m	N/A	N/A
1a.Distance from Stm. M.H. <u>3948</u> toward Stm. M.H. <u>3950</u> to lot service connection point is:	N/A	N/A	7.85m
2. Main Size at connection point is	200mmØ	200mmØ	250mmØ
3. Invert of service at main conn. stub point is	581.92m	581.46m	581.83m
4. Invert at service end is	582.50m	582.28m	582.50m
5. Cover at property line in meters	2.44m	2.44m	2.44m
6. Survey Date:AUG 2015 Book Ref.:1140-13 By:FORTWOOD HOMES LTD.			

SANITARY HISTORY:

DATE INSTALLED: AUG 2015

INSTALLED BY: FORTWOOD HOMES LTD.

WATER HISTORY:

DATE INSTALLED: AUG 2015

INSTALLED BY: FORTWOOD HOMES LTD.

STORM HISTORY:

DATE INSTALLED: AUG 2015

INSTALLED BY: FORTWOOD HOMES LTD.