

# City of Prince George

## HISTORY SHEET

PID: 029-917-689

Scale: 1:500

Legal: LOT 9

D.L.: 2014

PLAN: EPP53901

Address: 7126 FOXRIDGE COURT

Sanitary Connection:#	SIZE: 100mmØ	MATERIAL: PVC	INV. AT R 582.72m	CONNECTED
-----------------------	--------------	---------------	-------------------	-----------

Water Connection:#	SIZE: 19mmØ	MATERIAL: COPPER	INV. AT R 582.61m	CONNECTED
--------------------	-------------	------------------	-------------------	-----------

Storm Connection:#	SIZE: 100mmØ	MATERIAL: PVC	INV. AT R 582.72m	CONNECTED
--------------------	--------------	---------------	-------------------	-----------

Cash Receipt No's:	WATER	SANITARY	STORM
--------------------	-------	----------	-------

CURB FROM PROPERTY LINE	5m	PAVEMENT WIDTH	10m
-------------------------	----	----------------	-----

HYDRO	75mm DB2	U/G CONNECTION	✓
-------	----------	----------------	---


TELEPHONE	100mm DB2	U/G CONNECTION	✓
-----------	-----------	----------------	---

GAS	42 PROP/P.E.
-----	--------------

Information Sheets: REF. DWGS. L&M ENGINEERING LTD. JOB. 1282-11 DWGS.

Comments:	CS CURB STOP CO CLEAN OUT	WDS WATER SERVICE SWS STORM SERVICE SSS SANITARY SERVICE	HDS HYDRO SERVICE CDS CABLE SERVICE TDS TELECOMMUNICATIONS	GAS GAS E ELECTRICAL
-----------	------------------------------	--	--	-------------------------

**THE INFORMATION CONTAINED HEREIN IS FOR INTERNAL USE ONLY.  
NOT TO BE RELIED UPON UNLESS CONFIRMED BY THE SITE INSPECTION AND/OR INVESTIGATION**

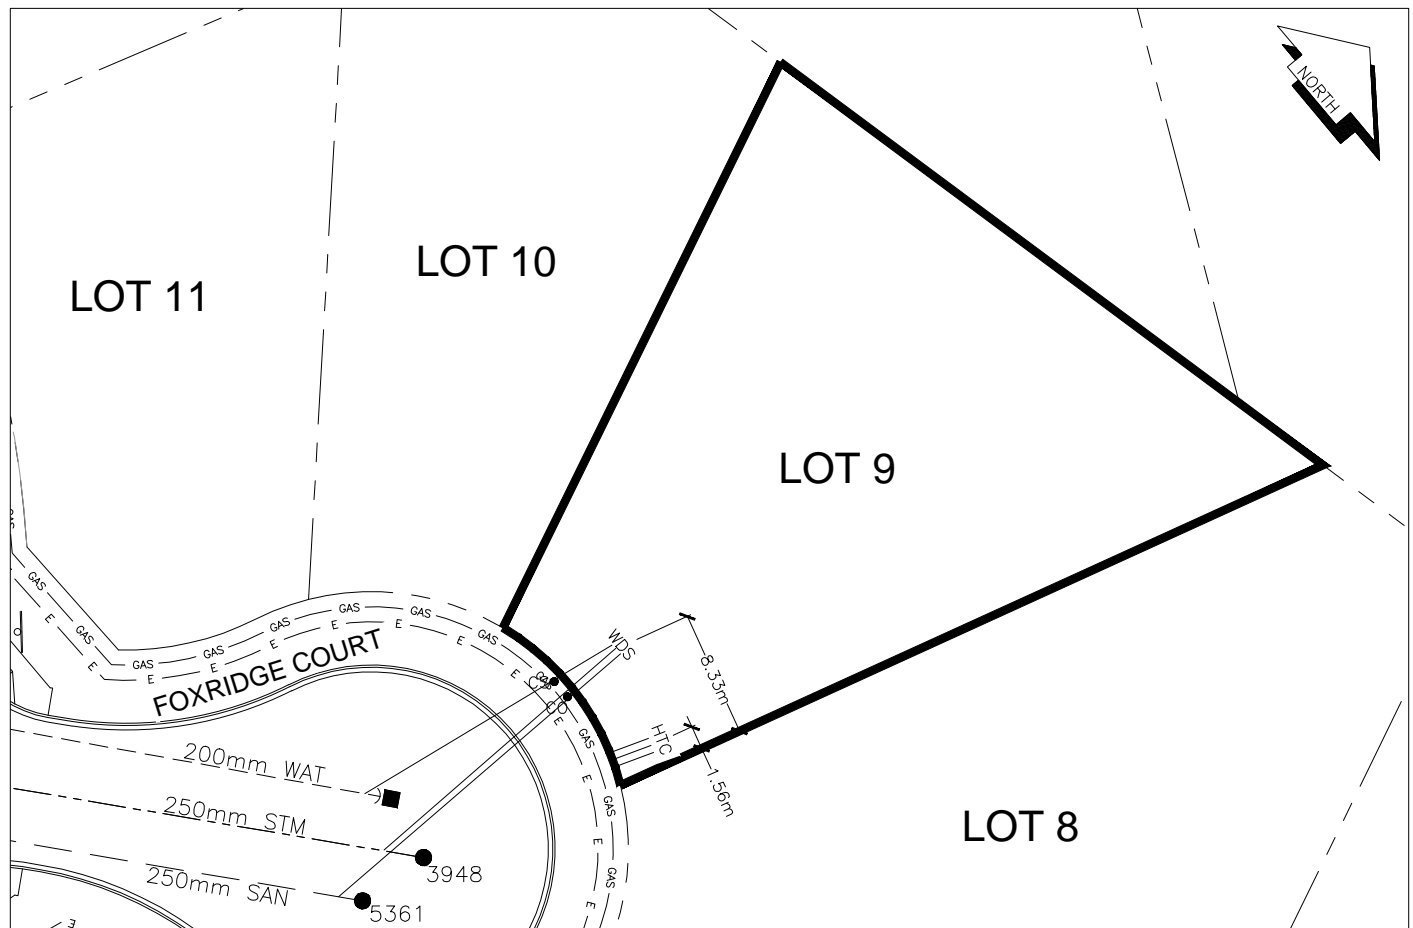

SANITARY, STORM & WATER SERVICE INVERTS	SANITARY	WATER	STORM
1. Distance from San. M.H. <u>5361</u> toward San. M.H. <u>5176</u> to lot service connection point is:	1.70m	N/A	N/A
1a.Distance from Stm. M.H. <u>3948</u> toward Stm. M.H. <u>3950</u> to lot service connection point is:	N/A	N/A	2.65m
2. Main Size at connection point is	200mmØ	200mmØ	250mmØ
3. Invert of service at main conn. stub point is	581.97m	581.56m	581.94m
4. Invert at service end is	582.80m	582.70m	582.79m
5. Cover at property line in meters	2.19m	2.38m	2.19m
6. Survey Date:AUG 2015    Book Ref.:1140-13    By:FORTWOOD HOMES LTD.			

**SANITARY HISTORY:**

DATE INSTALLED: AUG 2015

INSTALLED BY: FORTWOOD HOMES LTD.

---

---

**WATER HISTORY:**

DATE INSTALLED: AUG 2015

INSTALLED BY: FORTWOOD HOMES LTD.

---

---

**STORM HISTORY:**

DATE INSTALLED: AUG 2015

INSTALLED BY: FORTWOOD HOMES LTD.

---

---

