

City of Prince George

HISTORY SHEET

PID: 029-917-751

Scale: 1:500

Legal: LOT 16

D.L.: 2014

PLAN: EPP53901

Address: 7030 STONECREEK PLACE

Sanitary Connection:#	SIZE: 100mmØ	MATERIAL: PVC	INV. AT R 583.91m	CONNECTED
-----------------------	--------------	---------------	-------------------	-----------

Water Connection:#	SIZE: 19mmØ	MATERIAL: COPPER	INV. AT R 583.86m	CONNECTED
--------------------	-------------	------------------	-------------------	-----------

Storm Connection:#	SIZE: 100mmØ	MATERIAL: PVC	INV. AT R 583.91m	CONNECTED
--------------------	--------------	---------------	-------------------	-----------

Cash Receipt No's:	WATER	SANITARY	STORM
--------------------	-------	----------	-------

CURB FROM PROPERTY LINE	5m	PAVEMENT WIDTH	10m
-------------------------	----	----------------	-----

HYDRO	75mm DB2	U/G CONNECTION	✓
-------	----------	----------------	---


TELEPHONE	100mm DB2	U/G CONNECTION	✓
-----------	-----------	----------------	---

GAS	42 PROP/P.E.		
-----	--------------	--	--

Information Sheets: REF. DWGS. L&M ENGINEERING LTD. JOB. 1282-11 DWGS.

Comments:	CS CURB STOP CO CLEAN OUT	SDS WATER SERVICE STORM SERVICE SANITARY SERVICE	HT HYDRO SERVICE CABLE SERVICE TELECOMMUNICATIONS	GAS ELECTRICAL
-----------	------------------------------	---	--	-------------------

THE INFORMATION CONTAINED HEREIN IS FOR INTERNAL USE ONLY.
NOT TO BE RELIED UPON UNLESS CONFIRMED BY THE SITE INSPECTION AND/OR INVESTIGATION

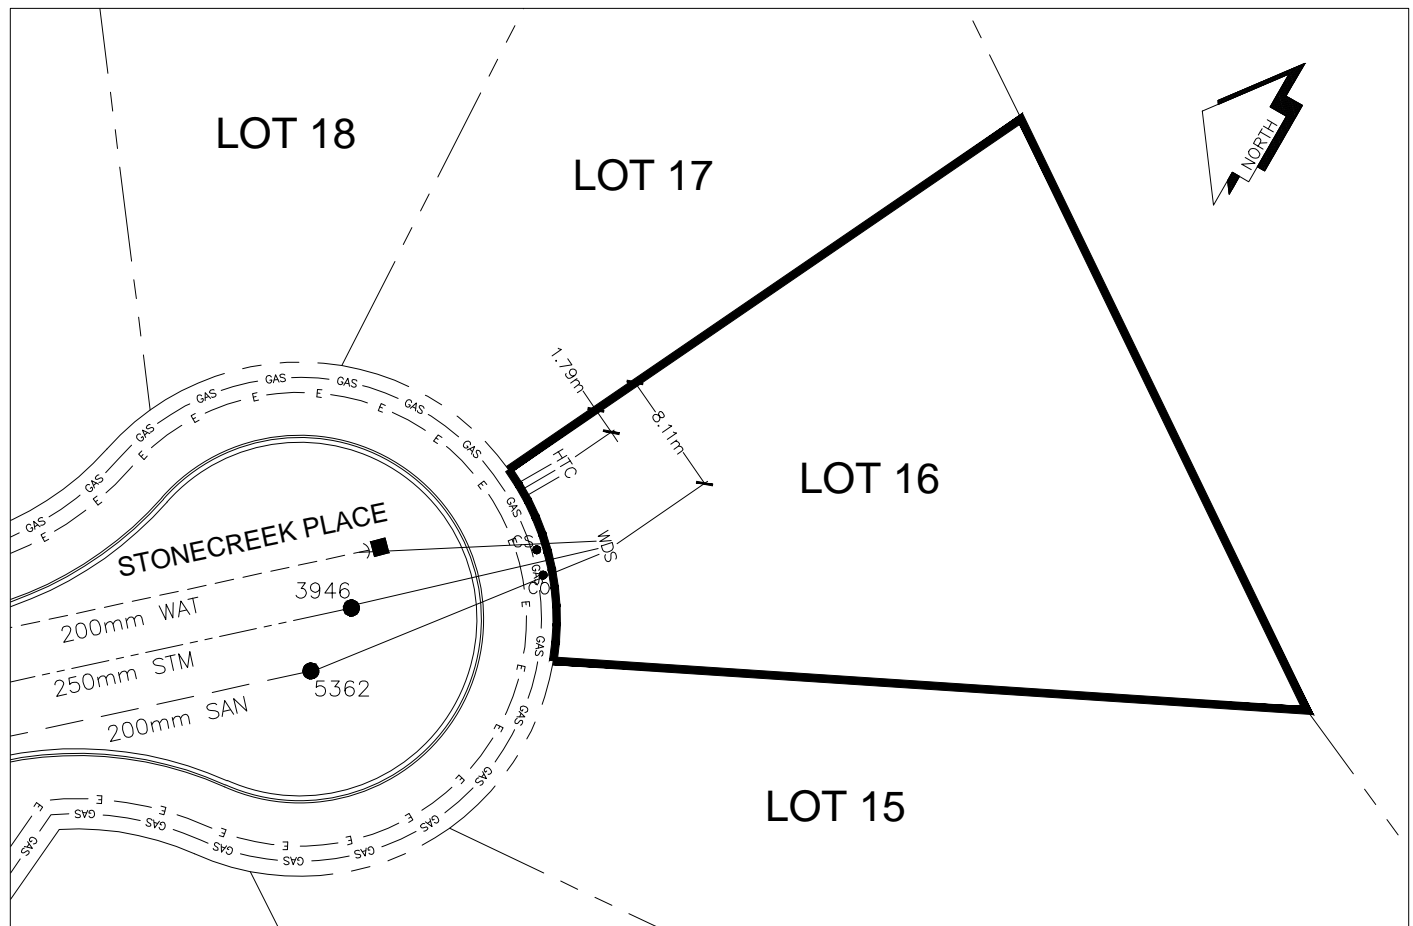

DATE INSTALLED: AUG 2015

INSTALLED BY: FORTWOOD HOMES LTD.

DATE INSTALLED: AUG 2015

INSTALLED BY: FORTWOOD HOMES LTD.

DATE INSTALLED: AUG 2015

INSTALLED BY: FORTWOOD HOMES LTD.