

City of Prince George

HISTORY SHEET

PID: 029-917-760

Scale: 1:500

Legal: LOT 17

D.L.: 2014

PLAN: EPP53901

Address: 7022 STONECREEK PLACE

Sanitary Connection:#	SIZE: 100mmØ	MATERIAL: PVC	INV. AT R 583.98m	CONNECTED
-----------------------	--------------	---------------	-------------------	-----------

Water Connection:#	SIZE: 19mmØ	MATERIAL: COPPER	INV. AT R 583.81m	CONNECTED
--------------------	-------------	------------------	-------------------	-----------

Storm Connection:#	SIZE: 100mmØ	MATERIAL: PVC	INV. AT R 583.98m	CONNECTED
--------------------	--------------	---------------	-------------------	-----------

Cash Receipt No's:	WATER	SANITARY	STORM
--------------------	-------	----------	-------

CURB FROM PROPERTY LINE	5m	PAVEMENT WIDTH	10m
-------------------------	----	----------------	-----

HYDRO	75mm DB2	U/G CONNECTION	✓
-------	----------	----------------	---

TELEPHONE	100mm DB2	U/G CONNECTION	✓
-----------	-----------	----------------	---


GAS	42 PROP/P.E.
-----	--------------

Information Sheets: REF. DWGS. L&M ENGINEERING LTD. JOB. 1282-11 DWGS.

Comments:

CS CURB STOP CO CLEAN OUT	WDS WATER SERVICE SWS STORM SERVICE SSS SANITARY SERVICE	HDS HYDRO SERVICE CDS CABLE SERVICE TDS TELECOMMUNICATIONS	GAS GAS E ELECTRICAL
------------------------------	--	--	-------------------------

**THE INFORMATION CONTAINED HEREIN IS FOR INTERNAL USE ONLY.
NOT TO BE RELIED UPON UNLESS CONFIRMED BY THE SITE INSPECTION AND/OR INVESTIGATION**

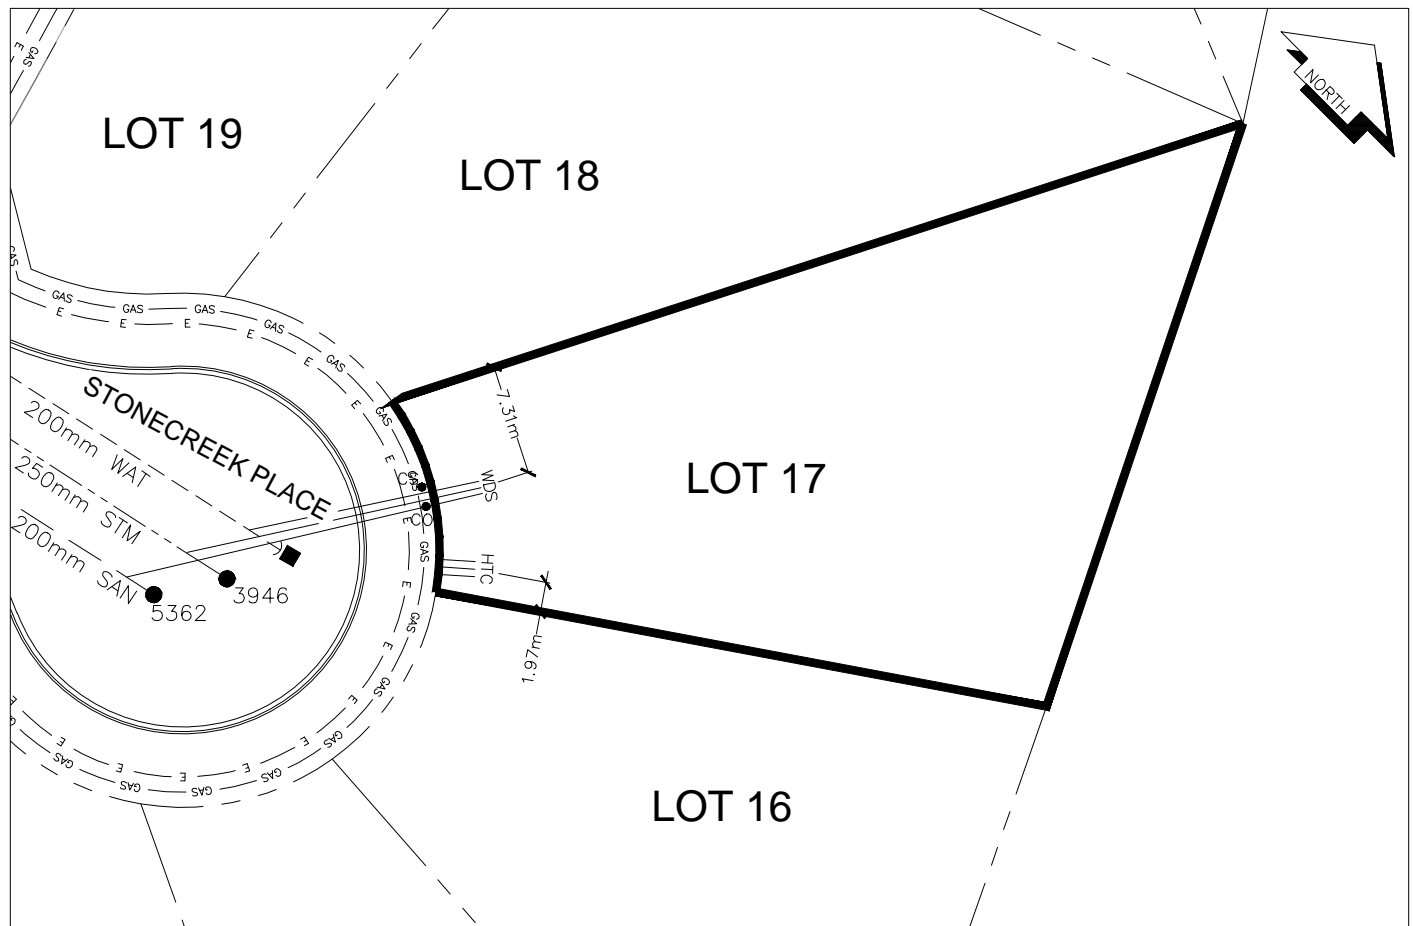

SANITARY, STORM & WATER SERVICE INVERTS	SANITARY	WATER	STORM
1. Distance from San. M.H. <u>5362</u> toward San. M.H. <u>5363</u> to lot service connection point is:	2.05m	N/A	N/A
1a.Distance from Stm. M.H. <u>3946</u> toward Stm. M.H. <u>3947</u> to lot service connection point is:	N/A	N/A	3.14m
2. Main Size at connection point is	200mmØ	200mmØ	250mmØ
3. Invert of service at main conn. stub point is	583.38m	582.85m	583.39m
4. Invert at service end is	584.04m	583.81m	584.05m
5. Cover at property line in meters	2.19m	2.44m	2.19m
6. Survey Date:AUG 2015 Book Ref.:1140-13 By:FORTWOOD HOMES LTD.			

SANITARY HISTORY:

DATE INSTALLED: AUG 2015

INSTALLED BY: FORTWOOD HOMES LTD.

WATER HISTORY:

DATE INSTALLED: AUG 2015

INSTALLED BY: FORTWOOD HOMES LTD.

STORM HISTORY:

DATE INSTALLED: AUG 2015

INSTALLED BY: FORTWOOD HOMES LTD.