

City of Prince George

HISTORY SHEET

PID: 029-917-786

Scale: 1:500

Legal: LOT 19

D.L.: 2014

PLAN: EPP53901


Address: 7006 STONECREEK PLACE

Sanitary Connection:#	SIZE: 100mmØ	MATERIAL: PVC	INV. AT R 583.83m	CONNECTED
Water Connection:#	SIZE: 19mmØ	MATERIAL: COPPER	INV. AT R 583.58m	CONNECTED
Storm Connection:#	SIZE: 100mmØ	MATERIAL: PVC	INV. AT R 583.86m	CONNECTED
Cash Receipt No's:	WATER	SANITARY	STORM	
CURB FROM PROPERTY LINE	5m	PAVEMENT WIDTH	10m	
HYDRO	75mm DB2	U/G CONNECTION	✓	
TELEPHONE	100mm DB2	U/G CONNECTION	✓	
GAS	42 PROP/P.E.			

Information Sheets: REF. DWGS. L&M ENGINEERING LTD. JOB. 1282-11 DWGS.

Comments: CS CURB STOP CO CLEAN OUT WDS WATER SERVICE SDC STORM SERVICE SDW SANITARY SERVICE HTC HYDRO SERVICE CDS CABLE SERVICE TCS TELECOMMUNICATIONS GAS GAS E ELECTRICAL

THE INFORMATION CONTAINED HEREIN IS FOR INTERNAL USE ONLY.
NOT TO BE RELIED UPON UNLESS CONFIRMED BY THE SITE INSPECTION AND/OR INVESTIGATION

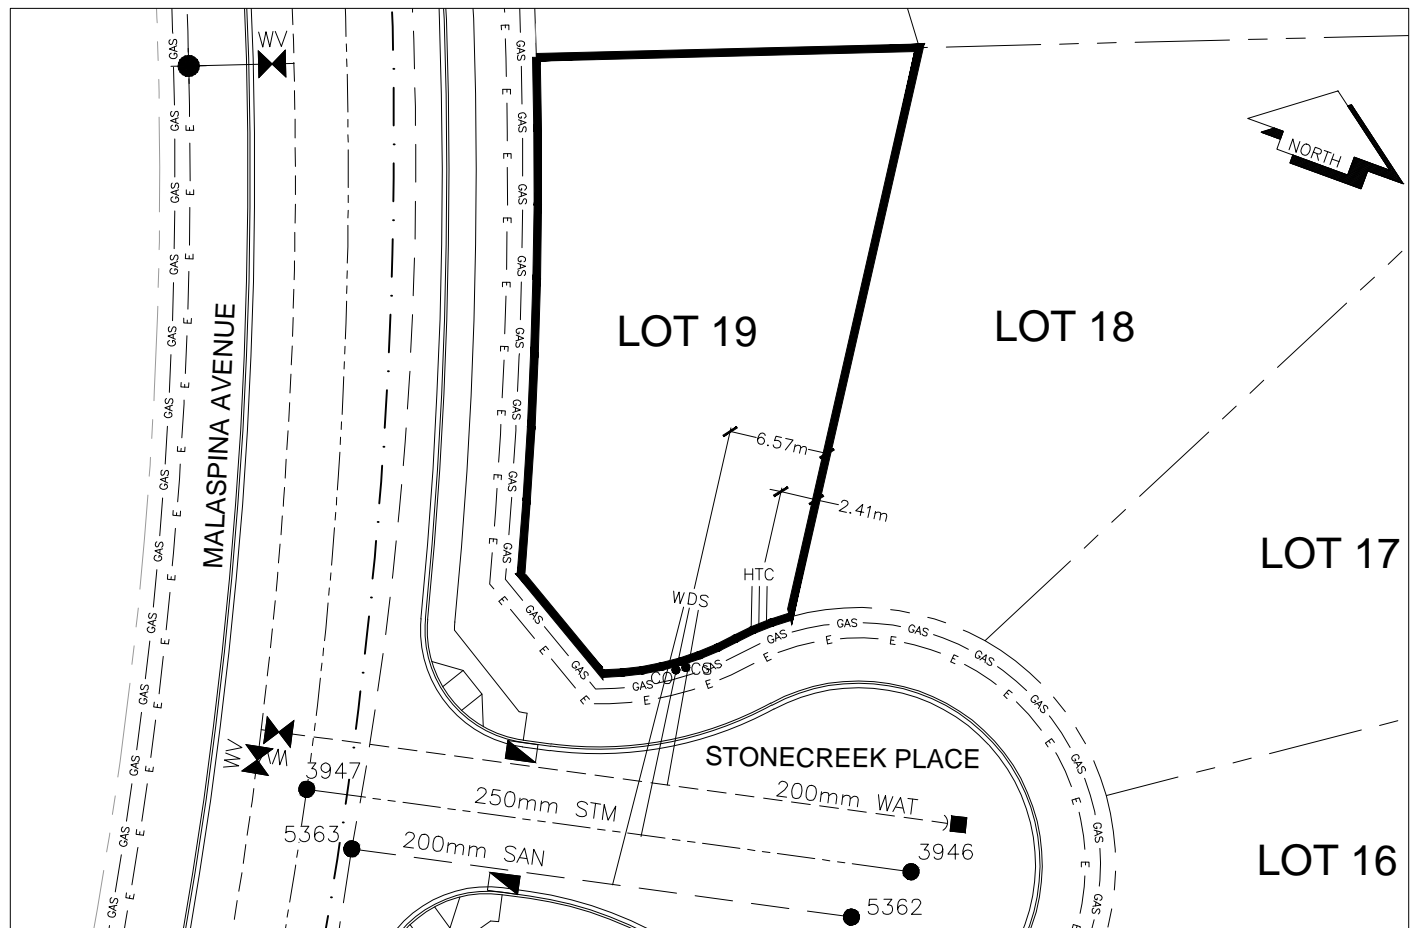

DATE INSTALLED: AUG 2015

INSTALLED BY: FORTWOOD HOMES LTD.

DATE INSTALLED: AUG 2015

INSTALLED BY: FORTWOOD HOMES LTD.

DATE INSTALLED: AUG 2015

INSTALLED BY: FORTWOOD HOMES LTD.