

# City of Prince George

## HISTORY SHEET

PID: 029-917-794

Scale: 1:500

Legal: LOT 20

D.L.: 2014

PLAN: EPP53901

Address: 6911 Malaspina Ave / 6915 Sunrise Pl

|                       |              |               |                   |           |
|-----------------------|--------------|---------------|-------------------|-----------|
| Sanitary Connection:# | SIZE: 100mmØ | MATERIAL: PVC | INV. AT R 583.11m | CONNECTED |
|-----------------------|--------------|---------------|-------------------|-----------|

|                    |             |                  |                   |           |
|--------------------|-------------|------------------|-------------------|-----------|
| Water Connection:# | SIZE: 19mmØ | MATERIAL: COPPER | INV. AT R 583.07m | CONNECTED |
|--------------------|-------------|------------------|-------------------|-----------|

|                    |              |               |                   |           |
|--------------------|--------------|---------------|-------------------|-----------|
| Storm Connection:# | SIZE: 100mmØ | MATERIAL: PVC | INV. AT R 583.15m | CONNECTED |
|--------------------|--------------|---------------|-------------------|-----------|

|                    |       |          |       |
|--------------------|-------|----------|-------|
| Cash Receipt No's: | WATER | SANITARY | STORM |
|--------------------|-------|----------|-------|

|                         |    |                |     |
|-------------------------|----|----------------|-----|
| CURB FROM PROPERTY LINE | 5m | PAVEMENT WIDTH | 10m |
|-------------------------|----|----------------|-----|

|       |          |                |   |
|-------|----------|----------------|---|
| HYDRO | 75mm DB2 | U/G CONNECTION | ✓ |
|-------|----------|----------------|---|


|           |           |                |   |
|-----------|-----------|----------------|---|
| TELEPHONE | 100mm DB2 | U/G CONNECTION | ✓ |
|-----------|-----------|----------------|---|

|     |              |  |  |
|-----|--------------|--|--|
| GAS | 42 PROP/P.E. |  |  |
|-----|--------------|--|--|

Information Sheets: REF. DWGS. L&M ENGINEERING LTD. JOB. 1282-11 DWGS.

Comments: CS CURB STOP CO CLEAN OUT WDS WATER SERVICE STORM SERVICE SANITARY SERVICE HTC HYDRO SERVICE CABLE SERVICE TELECOMMUNICATIONS GAS GAS ELECTRICAL

THE INFORMATION CONTAINED HEREIN IS FOR INTERNAL USE ONLY.  
NOT TO BE RELIED UPON UNLESS CONFIRMED BY THE SITE INSPECTION AND/OR INVESTIGATION

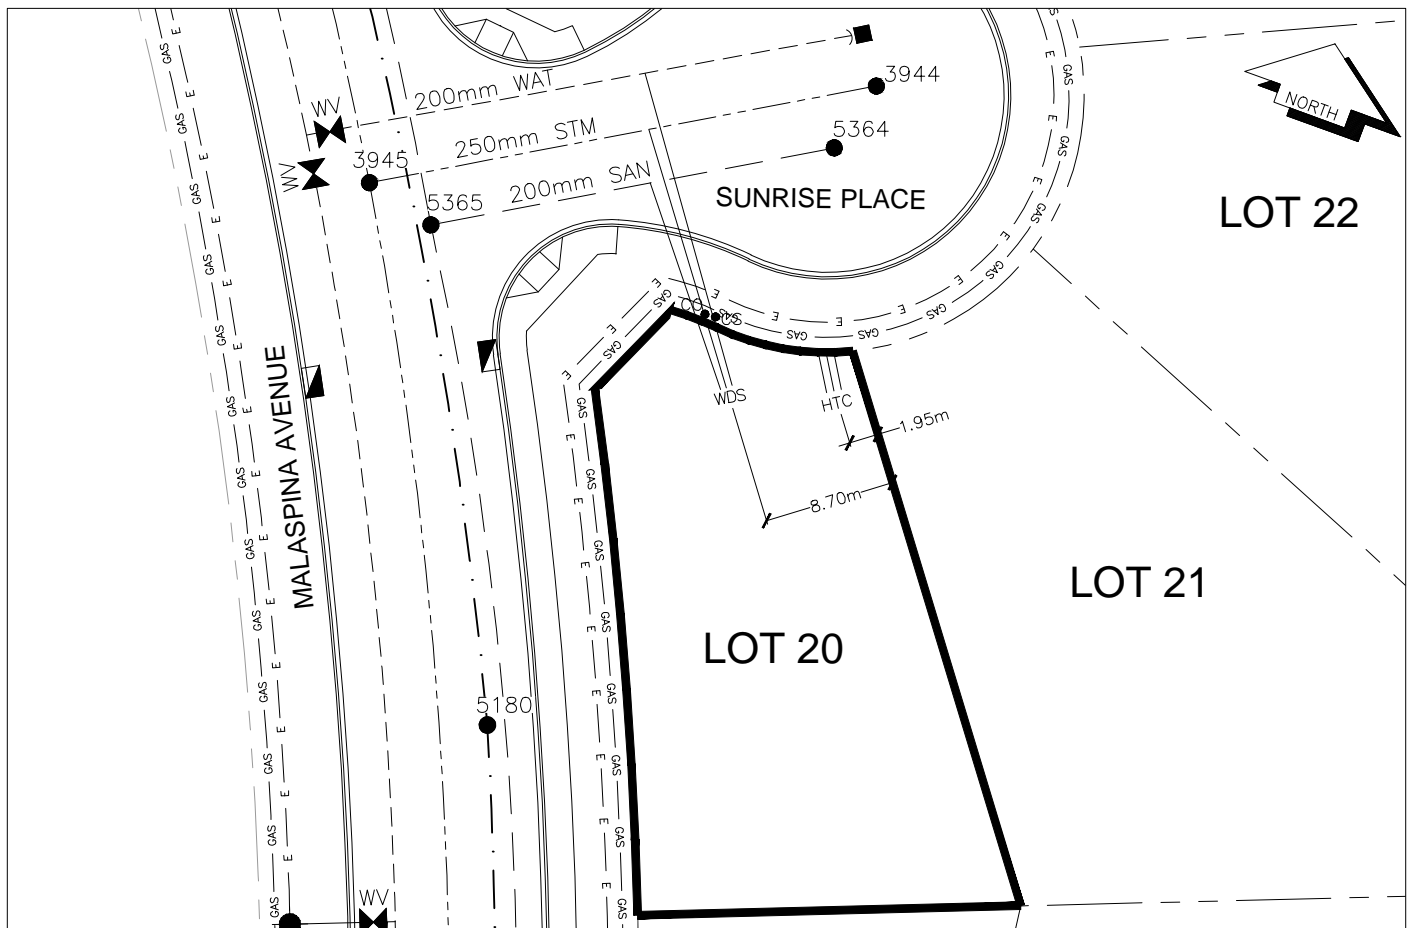

| SANITARY, STORM & WATER SERVICE INVERTS   | SANITARY | WATER   | STORM   |
|---|----------|---------|---------|
| 1. Distance from San. M.H. <u>5364</u> toward San. M.H. <u>5365</u> to lot service connection point is: | 12.28m   | N/A     | N/A     |
| 1a.Distance from Stm. M.H. <u>3944</u> toward Stm. M.H. <u>3945</u> to lot service connection point is: | N/A      | N/A     | 15.34m  |
| 2. Main Size at connection point is   | 200mmØ   | 200mmØ  | 250mmØ  |
| 3. Invert of service at main conn. stub point is  | 582.74m  | 582.16m | 582.55m |
| 4. Invert at service end is   | 583.25m  | 583.22m | 583.25m |
| 5. Cover at property line in meters   | 2.34m    | 2.49m   | 2.33m   |
| 6. Survey Date:AUG 2015    Book Ref.:1140-13    By:FORTWOOD HOMES LTD.                                  |          |         |         |
|   |          |         |         |
|   |          |         |         |
SANITARY HISTORY:

DATE INSTALLED: AUG 2015

INSTALLED BY: FORTWOOD HOMES LTD.

WATER HISTORY:

DATE INSTALLED: AUG 2015

INSTALLED BY: FORTWOOD HOMES LTD.

STORM HISTORY:

DATE INSTALLED: AUG 2015

INSTALLED BY: FORTWOOD HOMES LTD.