

# City of Prince George

## HISTORY SHEET

PID: 029-917-808

Scale: 1:500

Legal: LOT 21

D.L.: 2014

PLAN: EPP53901

Address: 6919 SUNRISE PLACE

Sanitary Connection:# SIZE: 100mmØ MATERIAL: PVC INV. AT R 583.18m CONNECTED

Water Connection:# SIZE: 19mmØ MATERIAL: COPPER INV. AT R 583.14m CONNECTED

Storm Connection:# SIZE: 100mmØ MATERIAL: PVC INV. AT R 583.21m CONNECTED

Cash Receipt No's: WATER SANITARY STORM

CURB FROM PROPERTY LINE 5m PAVEMENT WIDTH 10m

HYDRO 75mm DB2 U/G CONNECTION ✓

TELEPHONE 100mm DB2 U/G CONNECTION ✓


GAS 42 PROP/P.E.

Information Sheets: REF. DWGS. L&M ENGINEERING LTD. JOB. 1282-11 DWGS.

Comments: CS CURB STOP CO CLEAN OUT SDW WATER SERVICE STORM SERVICE SANITARY SERVICE HTI HYDRO SERVICE CABLE SERVICE TELECOMMUNICATIONS GAS GAS ELECTRICAL

THE INFORMATION CONTAINED HEREIN IS FOR INTERNAL USE ONLY.

NOT TO BE RELIED UPON UNLESS CONFIRMED BY THE SITE INSPECTION AND/OR INVESTIGATION

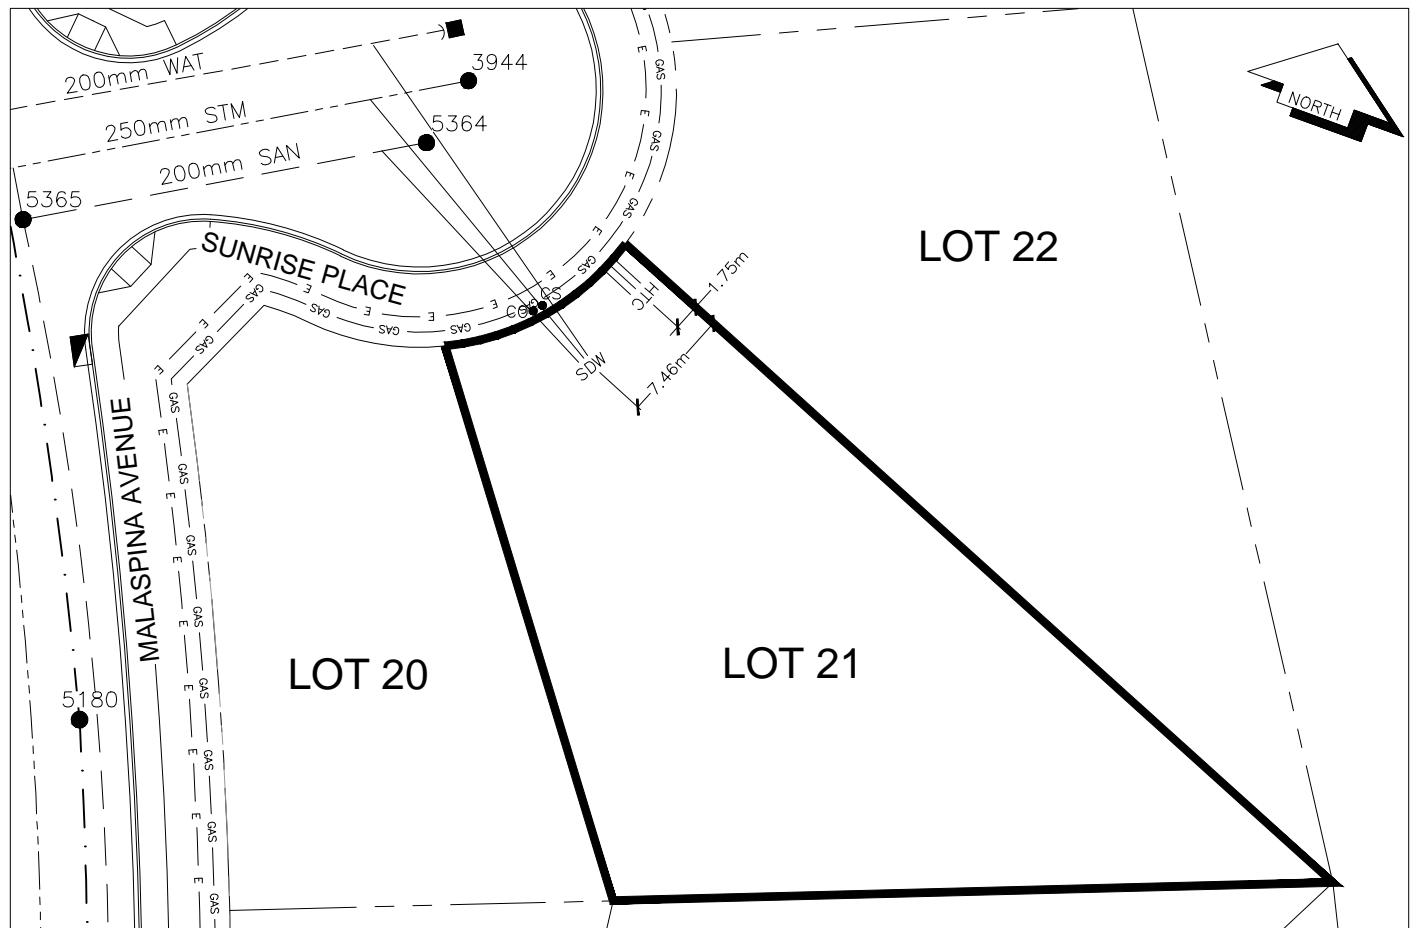

DATE INSTALLED: AUG 2015

INSTALLED BY: FORTWOOD HOMES LTD.

DATE INSTALLED: AUG 2015

INSTALLED BY: FORTWOOD HOMES LTD.

DATE INSTALLED: AUG 2015

INSTALLED BY: FORTWOOD HOMES LTD.