

City of Prince George

HISTORY SHEET

PID: 029-917-841

Scale: 1:500

Legal: LOT 25

D.L.: 2014

PLAN: EPP53901

Address: 6908 SUNRISE PLACE

Sanitary Connection:# SIZE: 100mmØ MATERIAL: PVC INV. AT R 583.30m CONNECTED

Water Connection:# SIZE: 19mmØ MATERIAL: COPPER INV. AT R 583.12m CONNECTED

Storm Connection:# SIZE: 100mmØ MATERIAL: PVC INV. AT R 583.31m CONNECTED

Cash Receipt No's: WATER SANITARY STORM

CURB FROM PROPERTY LINE 5m PAVEMENT WIDTH 10m

HYDRO 75mm DB2 U/G CONNECTION ✓


TELEPHONE 100mm DB2 U/G CONNECTION ✓

GAS 42 PROP/P.E.

Information Sheets: REF. DWGS. L&M ENGINEERING LTD. JOB. 1282-11 DWGS.

Comments: CS CURB STOP CO CLEAN OUT SDW WATER SERVICE STORM SERVICE SANITARY SERVICE HTC HYDRO SERVICE CABLE SERVICE TELECOMMUNICATIONS GAS GAS E ELECTRICAL

THE INFORMATION CONTAINED HEREIN IS FOR INTERNAL USE ONLY.
NOT TO BE RELIED UPON UNLESS CONFIRMED BY THE SITE INSPECTION AND/OR INVESTIGATION

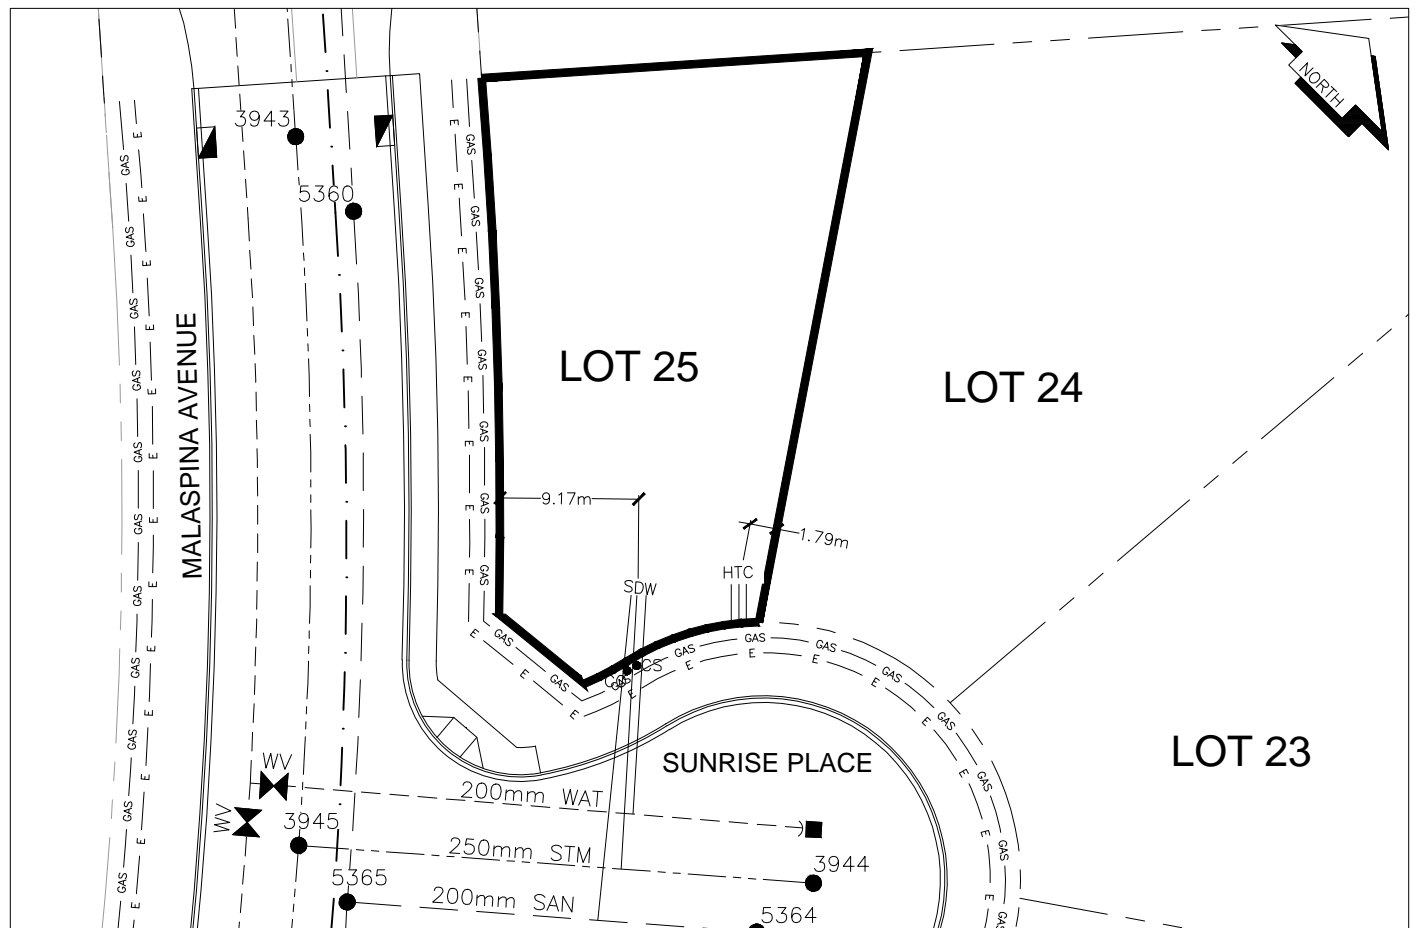

DATE INSTALLED: AUG 2015

INSTALLED BY: FORTWOOD HOMES LTD.

DATE INSTALLED: AUG 2015

INSTALLED BY: FORTWOOD HOMES LTD.

DATE INSTALLED: AUG 2015

INSTALLED BY: FORTWOOD HOMES LTD.