



City of Prince George History Sheet

PID:	029920914
SD/MU:	100420
WO:	

Civic Address: 4101 Brink Pl

Legal Description: Lot: 1 District Lot: 4221 Plan: EPP53690


Service Type	Diameter (mm)	Material	Invert Elev at main (m)	Invert Elev at property line (m)	Invert Elev at service end (m)	Distance into property (m)	Installation Date
Sanitary	200mm	PVC	-	-	-	-	January 1997
Water	40mm	Copper	-	-	-	4.70	January 1997
Storm	N/A	N/A	-	-	-	-	

Service Connection Location				Sanitary (m)	Storm (m)
Distance from downstream San MH	1582	towards upstream San MH	1589	41.74	
Distance from downstream Stm MH	-	towards upstream Stm MH	-		

Power	Size	Communications	Size	Cable	Size	Gas	Size
BC Hydro	-	Telus	-	Shaw	-	FortisBC	-
Underground Service		Underground Service		Underground Service			

Installed by:	Survey Date:	-
Comments:		

NOT TO SCALE The information contained herein is for internal use only.
Not to be relied on unless confirmed by site inspection and/or investigation.

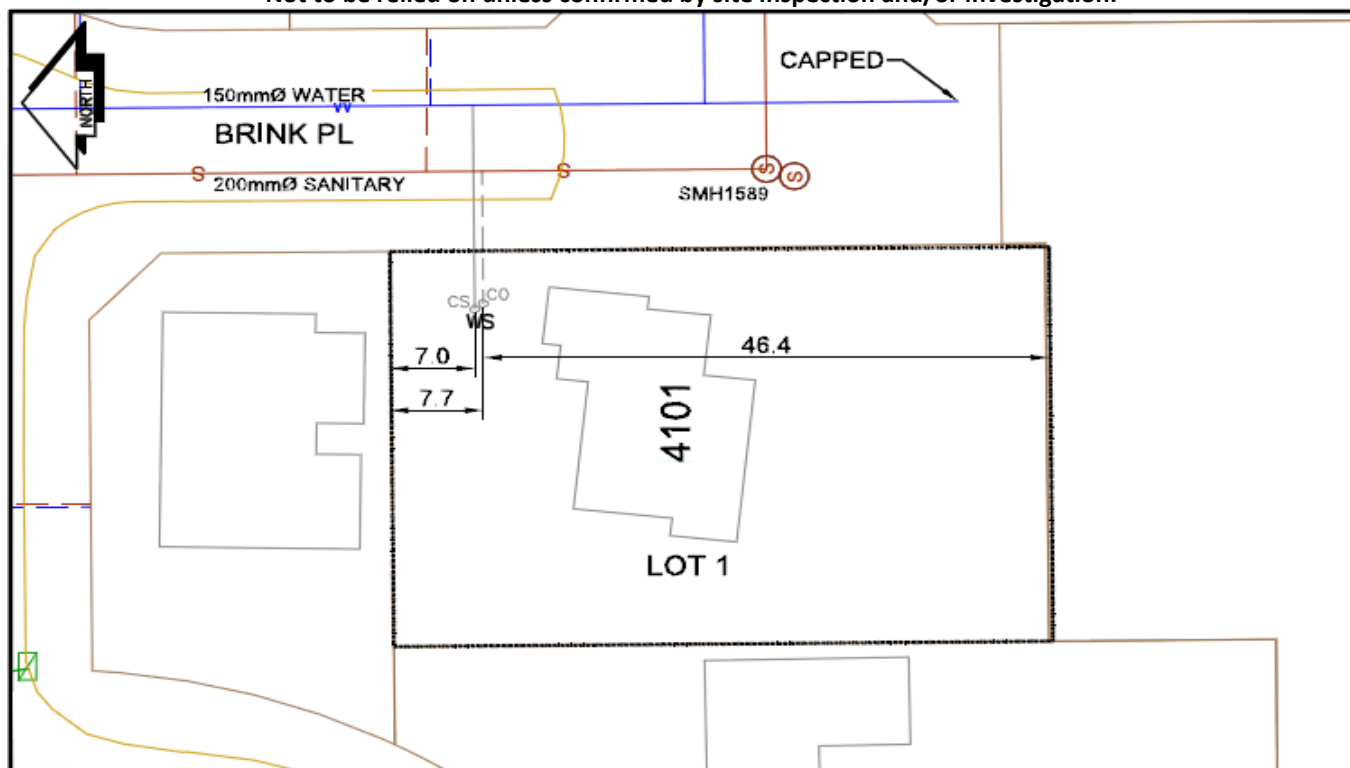

LEGEND:	CS CURB STOP	--- W WATER SERVICE	--- S SANITARY SERVICE	--- G GAS	--- D STORM SERVICE
	CO CLEAN OUT				

NOT TO SCALE