



City of Prince George History Sheet

PID:	029948789
MU:	101570
WO:	80810/ 80811
	80812

Civic Address: 2884 Andres Rd

Legal Description: Lot: A District Lot: 1433 Plan: EPP44842


Service Type	Diameter (mm)	Material	Invert Elev at main (m)	Invert Elev at property line (m)	Invert Elev at service end (m)	Distance into property (m)	Installation Date
Sanitary	100mm	PVC	-	-	-	-	May 2015
Water	20mm	Copper	-	-	-	-	May 2015
Storm	100mm	PVC	-	-	-	-	May 2015

Service Connection Location				Sanitary (m)	Storm (m)
Distance from downstream San MH	4088	towards upstream San MH	4089	71.20	
Distance from downstream Stm MH	1596	towards upstream Stm MH	1611		22.12

Power	Size	Communications	Size	Cable	Size	Gas	Size
BC Hydro	-	Telus	-	Shaw	-	FortisBC	-
Overhead Service		Overhead Service		Overhead Service			

Installed by:	City of Prince George forces	Survey Date:	-
Comments:			

NOT TO SCALE The information contained herein is for internal use only.
Not to be relied on unless confirmed by site inspection and/or investigation.

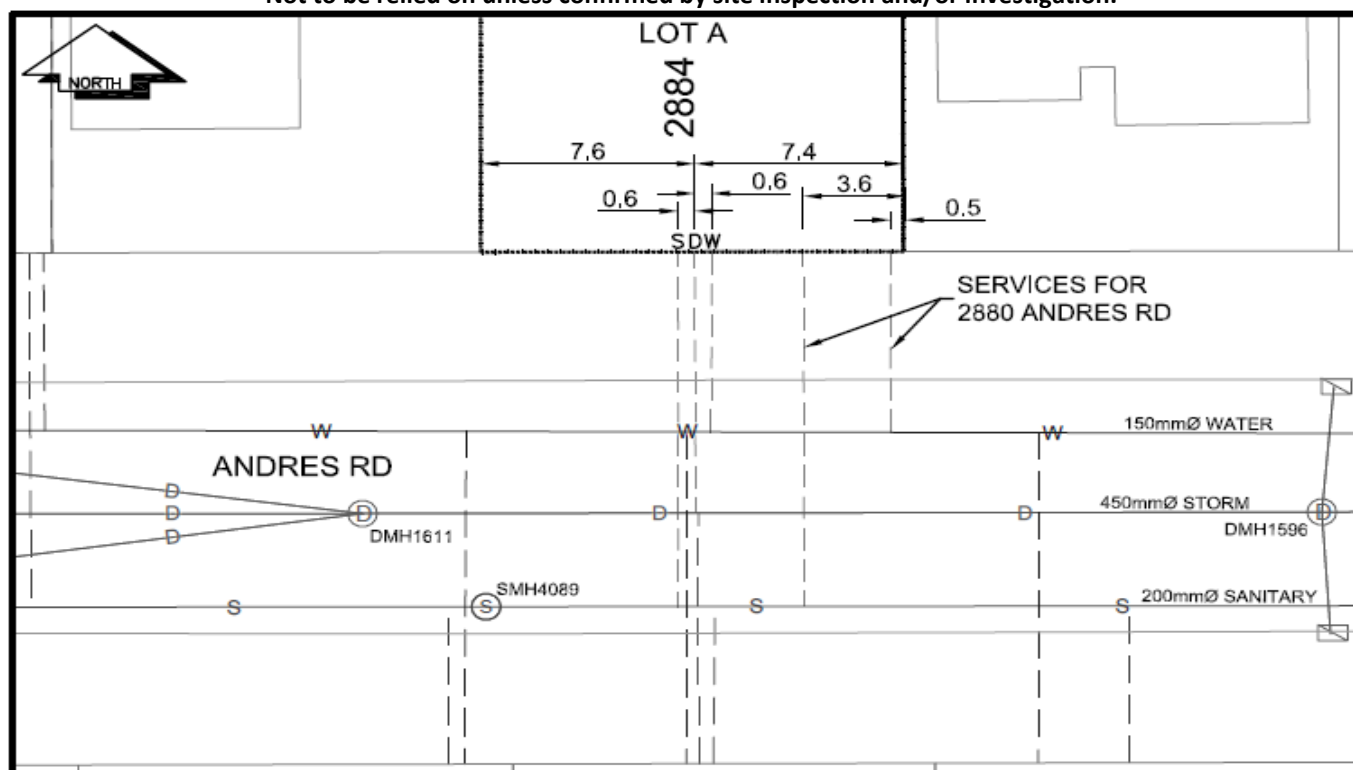

CS	CURB STOP	---	W	WATER SERVICE	---	D	STORM SERVICE
CO	CLEAN OUT	---	S	SANITARY SERVICE	---	G	GAS

NOT TO SCALE