



City of Prince George History Sheet

PID:	029948797
MU:	101570
WO:	

Civic Address: 2880 Andres Rd

Legal Description: Lot: B District Lot: 1433 Plan: EPP44842


Service Type	Diameter (mm)	Material	Invert Elev at main (m)	Invert Elev at property line (m)	Invert Depth at service end (m)	Distance into property (m)	Installation Date
Sanitary	100mm	PVC	-	-	2.51	-	January 1980
Water	20mm	Copper	-	-	-	-	January 1980
Storm	N/A	N/A	-	-	-	-	-

Service Connection Location				Sanitary (m)	Storm (m)
Distance from downstream San MH	4088	towards upstream San MH	4089	67.57	
Distance from downstream Stm MH	-	towards upstream Stm MH	-		-

Power	Size	Communications	Size	Cable	Size	Gas	Size
BC Hydro	-	Telus	-	Shaw	-	FortisBC	-
Overhead Service		Overhead Service		Overhead Service			

Installed by:	Survey Date:	-
Comments:		

NOT TO SCALE The information contained herein is for internal use only.
Not to be relied on unless confirmed by site inspection and/or investigation.

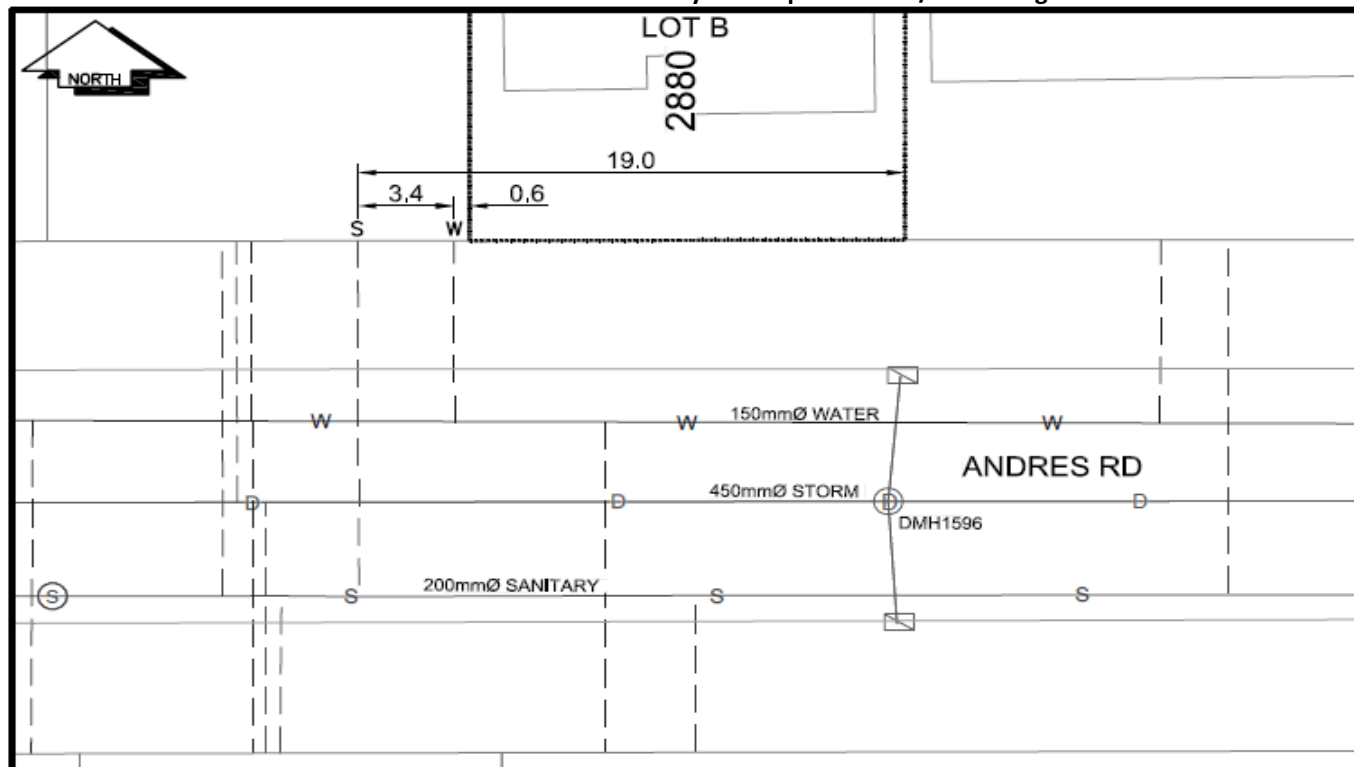

LEGEND:

CS ^o CURB STOP	--- W WATER SERVICE	--- S STORM SERVICE
CO ^o CLEAN OUT	--- S SANITARY SERVICE	--- G GAS

NOT TO SCALE