



City of Prince George History Sheet

PID:	029954461
MU:	101717
WO:	87929/87931

Civic Address: 8277 Peter Rd

Legal Description: Lot: 1 District Lot: 2424 Plan: EPP64032


Service Type	Diameter (mm)	Material	Invert Elev at main (m)	Invert Elev at property line (m)	Invert Elev at service end (m)	Distance into property (m)	Installation Date
Sanitary	100mm	PVC	750.75	751.44	-	-	June 2016
Water	20mm	Copper	750.22	751.40	-	-	June 2016
Storm	N/A	N/A	-	-	-	-	

Service Connection Location				Sanitary (m)	Storm (m)
Distance from downstream San MH	106	towards upstream San MH	108	71.53	
Distance from downstream Stm MH	-	towards upstream Stm MH	-		

Power	Size	Communications	Size	Cable	Size	Gas	Size
BC Hydro	-	Telus	-	Shaw	-	FortisBC	-
Overhead Service		Overhead Service		Overhead Service			

Installed by:	City of Prince George forces	Survey Date:	-
Comments:			

NOT TO SCALE The information contained herein is for internal use only.
Not to be relied on unless confirmed by site inspection and/or investigation.

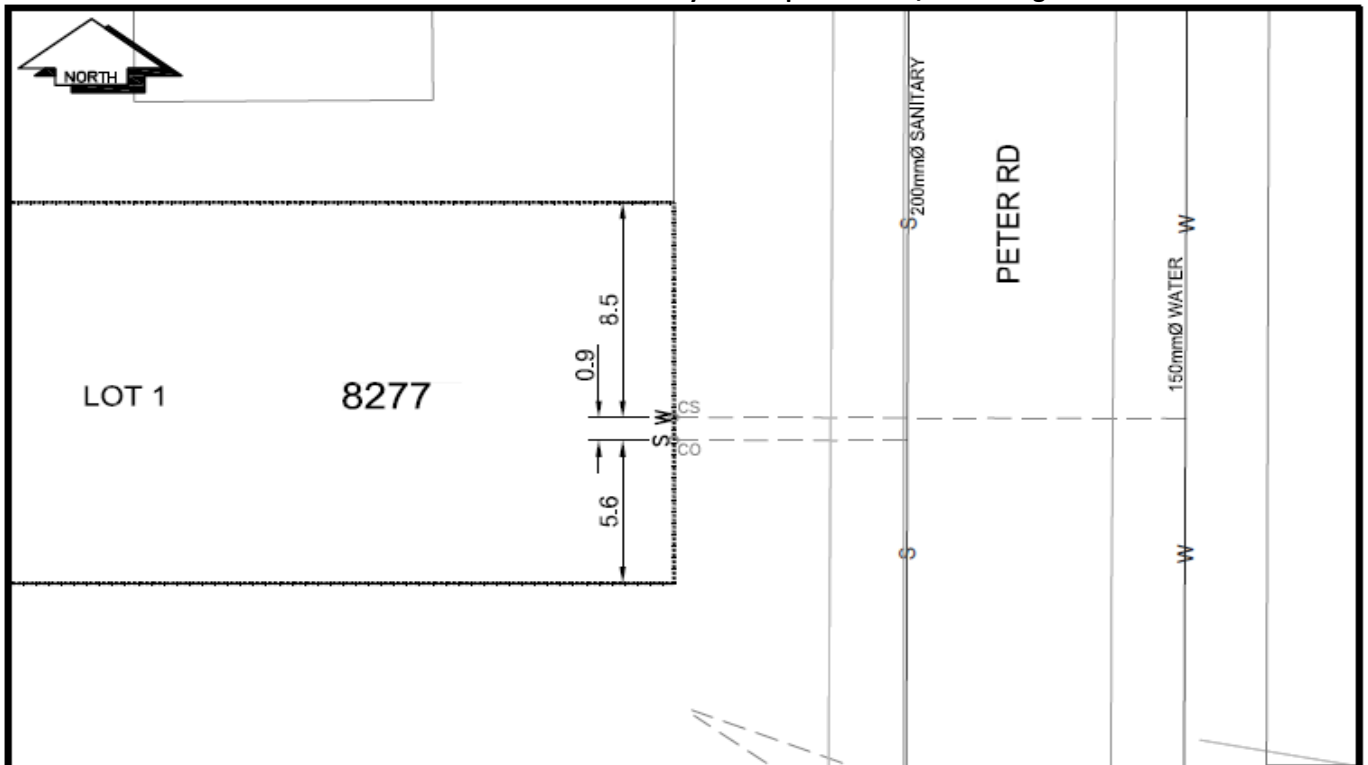

LEGEND:	CS CURB STOP	--- W WATER SERVICE	--- S SANITARY SERVICE	--- D STORM SERVICE	--- G GAS
	CO CLEAN OUT				

NOT TO SCALE