



City of Prince George
History Sheet

PID:	029960851
SD/MU:	
WO:	

Civic Address: 1165 5th Ave

Legal Description: Lot: PCL C Block: 165 (CA5569873) District Lot: 343 Plan: 1268


Service Type	Diameter (mm)	Material	Invert Elev at main (m)	Invert Elev at property line (m)	Invert Depth at service end (m)	Distance into property (m)	Installation Date
Sanitary	100mm	AC	567.46	567.68	2.01	-	October 1974
Water	25mm	Copper	-	-	-	-	January 1962
Storm	150mm	AC	-	569.04	1.41	-	January 1964

Service Connection Location	Sanitary (m)	Storm (m)
Distance from downstream San MH 3114 towards upstream San MH 3112	24.97	
150mm Storm service connected to Stm MH 3043		

Power	Size	Communications	Size	Cable	Size	Gas	Size
BC Hydro	-	Telus	-	Shaw	-	FortisBC	-
Overhead Service		Overhead Service		Overhead Service			

Installed by:	Survey Date:	-
Comments:		

NOT TO SCALE The information contained herein is for internal use only.
Not to be relied on unless confirmed by site inspection and/or investigation.

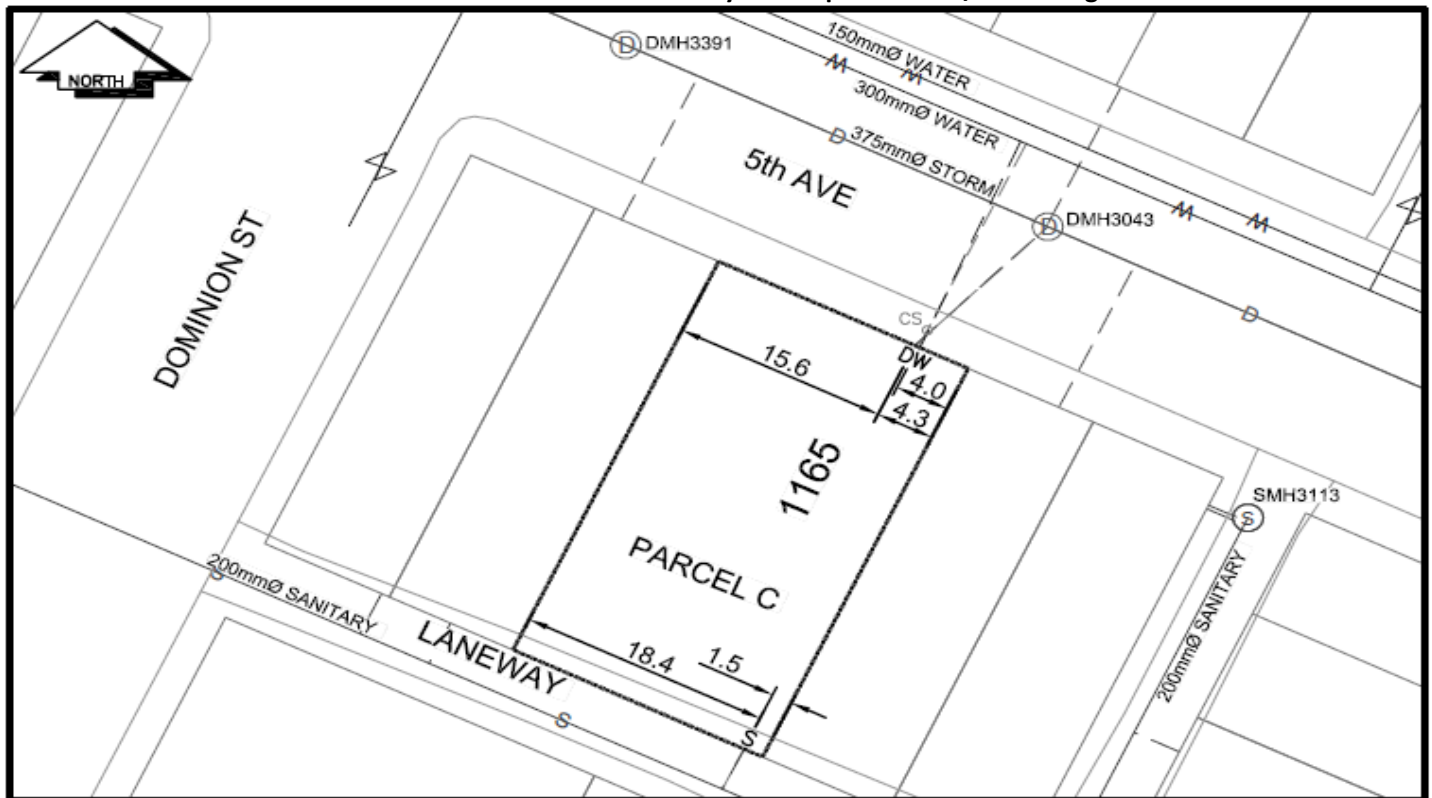

CS ^o CURB STOP	--- WATER SERVICE	--- STORM SERVICE
CO ^o CLEAN OUT	--- SANITARY SERVICE	--- GAS
⊗ WATER VALVE	⊗ FIRE HYDRANT	--- ENCUMBRANCE

NOT TO SCALE