



PID:	029-974-801
SD/MU:	SD100508
WO:	


LEGAL DESCRIPTION: LOT 7 DISTRICT LOT 4376 PLAN EPP63574

[illegible]

ELECTRICAL / COMMUNICATIONS / GAS			
TYPE	PROVIDER	SIZE AND MATERIAL	LOCATION (UNDERGROUND/ OVERHEAD)
ELECTRICAL	BC HYDRO	75mm DB2	UNDERGROUND
COMMUNICATION	TELUS	50mm DB2	UNDERGROUND
COMMUNICATION	SHAW	50mm DB2	UNDERGROUND
GAS	FORTISBC	42 PROP/P.E.	UNDERGROUND

INFORMATION SHEETS: L&M ENGINEERING LIMITED PROJECT NUMBER 1145-20	SURVEY DATE: JUNE 2016
INSTALLED BY: JR CONSTRUCTION & CONSULTING SERVICES LTD.	
COMMENTS:	

THE INFORMATION CONTAINED HEREIN IS FOR INTERNAL USE ONLY.
NOT TO BE RELIED UPON UNLESS CONFIRMED BY SITE INVESTIGATION.

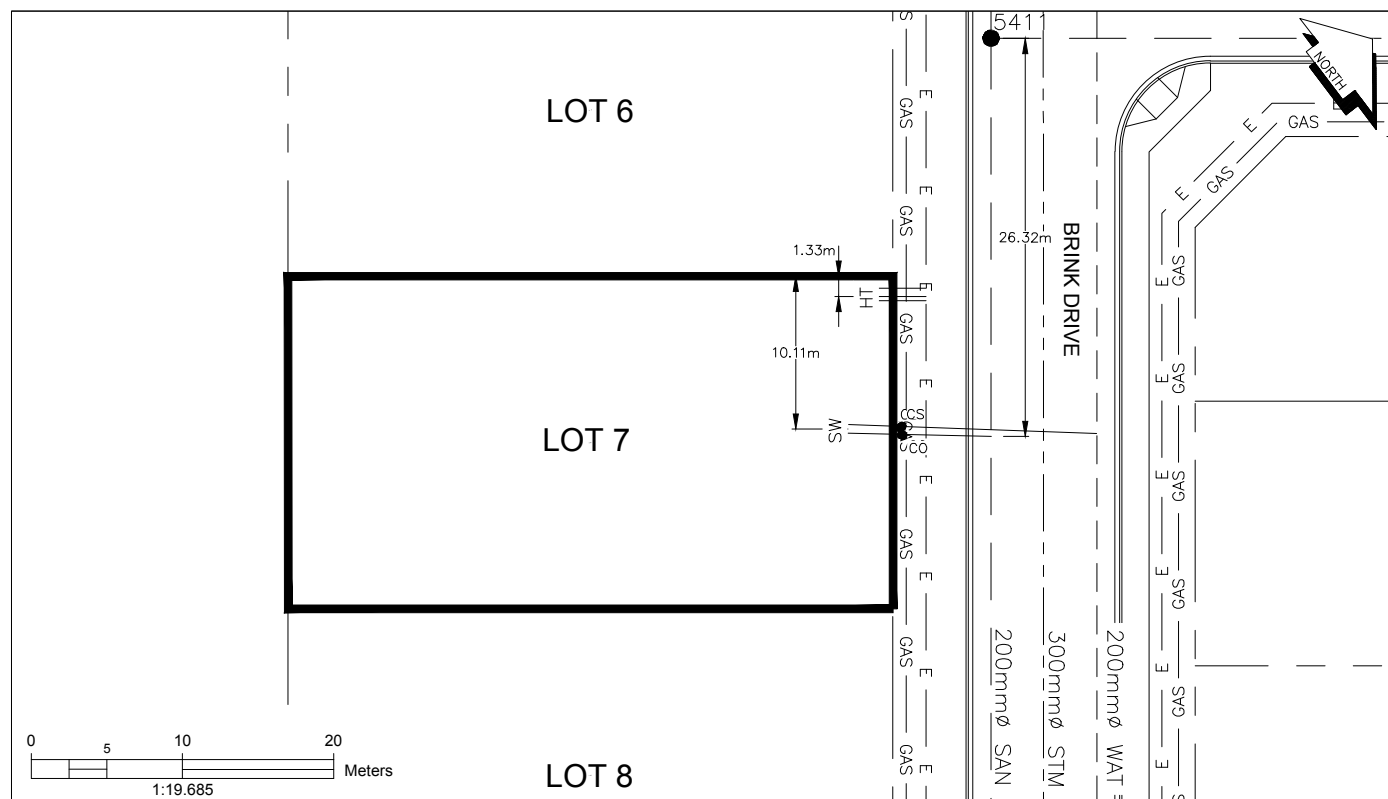

LEGEND:

- CS ● CURB STOP — W WATER SERVICE — H HYDRO SERVICE — GAS — GAS
CO ● CLEAN OUT — S STORM SERVICE — T TELECOMMUNICATIONS — E — ELECTRICAL