



CITY OF  
PRINCE GEORGE

# City of Prince George HISTORY SHEET

|        |             |
|--------|-------------|
| PID:   | 029-974-810 |
| SD/MU: | SD100508    |
| WO:    |             |

CIVIC ADDRESS: 3971 BRINK DRIVE

LEGAL DESCRIPTION: LOT 8 DISTRICT LOT 4376 PLAN EPP63574

| SERVICE TYPE | DIAMETER (mm) | MATERIAL | INVERT ELEV AT MAIN (m) | INVERT ELEV AT PROPERTY LINE (m) | INVERT ELEV AT SERVICE END (m) | COVER AT PROPERTY LINE (m) | DISTANCE INTO PROPERTY (m) | INSTALLATION DATE |
|--------------|---------------|----------|-------------------------|----------------------------------|--------------------------------|----------------------------|----------------------------|-------------------|
| SANITARY     | 100           | PVC      | 596.99                  | 597.20                           | 597.26                         | 3.07                       | 3.00                       | MAY 2016          |
| WATER        | 19            | COPPER   | 597.02                  | 597.22                           | 597.31                         | 3.13                       | 3.00                       | MAY 2016          |
| STORM        | N/A           | N/A      | N/A                     | N/A                              | N/A                            | N/A                        | N/A                        | N/A               |

## ELECTRICAL / COMMUNICATIONS / GAS

| TYPE          | PROVIDER | SIZE AND MATERIAL | LOCATION ( UNDERGROUND/ OVERHEAD) |
|---------------|----------|-------------------|-----------------------------------|
| ELECTRICAL    | BC HYDRO | 75mm DB2          | UNDERGROUND                       |
| COMMUNICATION | TELUS    | 50mm DB2          | UNDERGROUND                       |
| COMMUNICATION | SHAW     | 50mm DB2          | UNDERGROUND                       |
| GAS           | FORTISBC | 42 PROP/P.E.      | UNDERGROUND                       |


INFORMATION SHEETS: L&M ENGINEERING LIMITED PROJECT NUMBER 1145-20

SURVEY DATE: JUNE 2016

INSTALLED BY: JR CONSTRUCTION & CONSULTING SERVICES LTD.

COMMENTS:

THE INFORMATION CONTAINED HEREIN IS FOR INTERNAL USE ONLY.  
NOT TO BE RELIED UPON UNLESS CONFIRMED BY SITE INVESTIGATION.

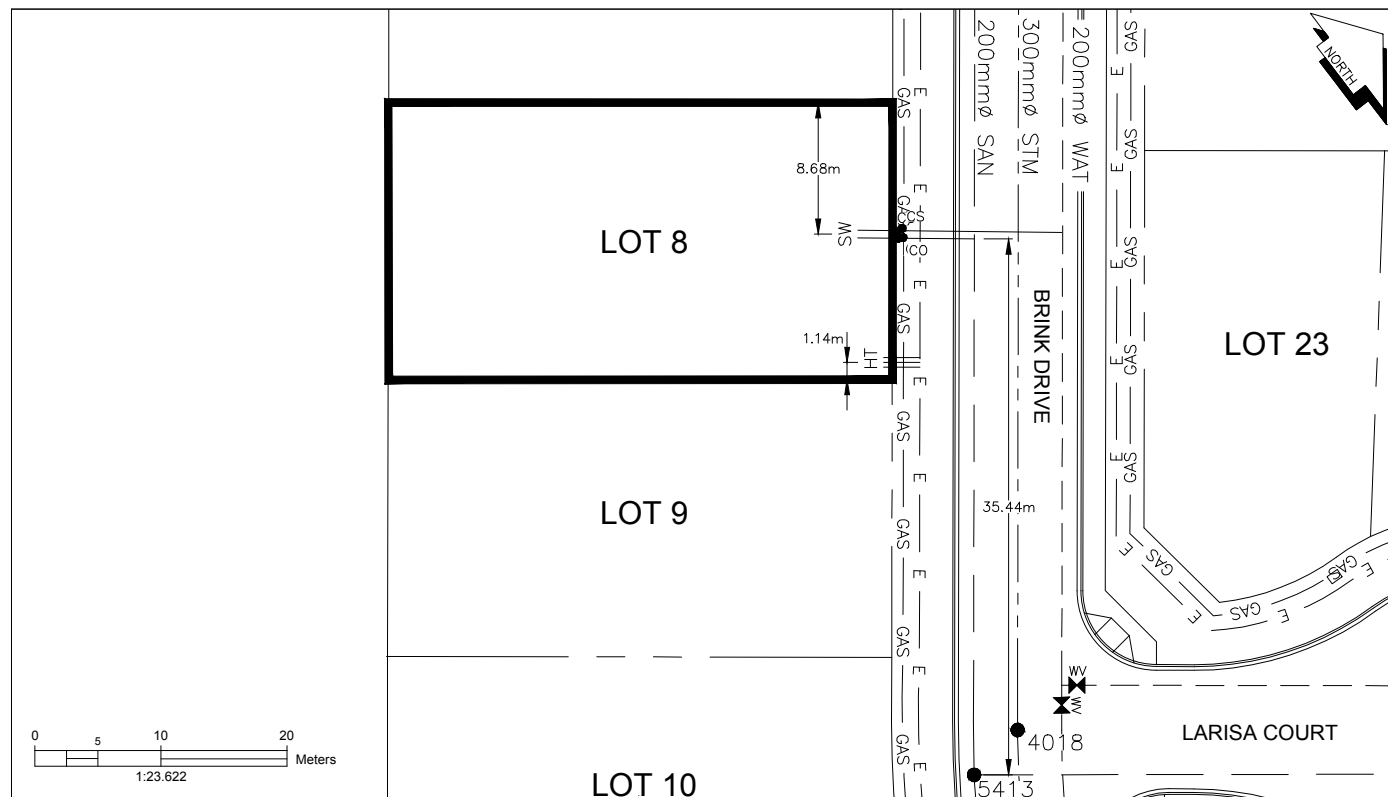

## LEGEND:

CS CURB STOP  
CO CLEAN OUT

W WATER SERVICE  
S STORM SERVICE  
SAN SANITARY SERVICE

H HYDRO SERVICE  
T TELECOMMUNICATIONS

GAS GAS  
E ELECTRICAL