



CITY OF
PRINCE GEORGE

City of Prince George HISTORY SHEET

PID:	029-975-247
SD/MU:	SD100508
WO:	

CIVIC ADDRESS: 4111 ZANETTE PLACE


LEGAL DESCRIPTION: LOT 51 DISTRICT LOT 4376 PLAN EPP63574

SERVICE TYPE	DIAMETER (mm)	MATERIAL	INVERT ELEV AT MAIN (m)	INVERT ELEV AT PROPERTY LINE (m)	INVERT ELEV AT SERVICE END (m)	COVER AT PROPERTY LINE (m)	DISTANCE INTO PROPERTY (m)	INSTALLATION DATE
SANITARY	100	PVC	598.46	598.67	598.75	2.60	3.00	MAY 2016
WATER	19	COPPER	598.10	598.63	598.78	2.72	3.00	MAY 2016
STORM	N/A	N/A	N/A	N/A	N/A	N/A	N/A	N/A

ELECTRICAL / COMMUNICATIONS / GAS			
TYPE	PROVIDER	SIZE AND MATERIAL	LOCATION (UNDERGROUND/ OVERHEAD)
ELECTRICAL	BC HYDRO	75mm DB2	UNDERGROUND
COMMUNICATION	TELUS	50mm DB2	UNDERGROUND
COMMUNICATION	SHAW	50mm DB2	UNDERGROUND
GAS	FORTISBC	42 PROP/P.E.	UNDERGROUND

INFORMATION SHEETS: L&M ENGINEERING LIMITED PROJECT NUMBER 1145-20	SURVEY DATE: JUNE 2016
INSTALLED BY: JR CONSTRUCTION & CONSULTING SERVICES LTD.	
COMMENTS:	

THE INFORMATION CONTAINED HEREIN IS FOR INTERNAL USE ONLY.
NOT TO BE RELIED UPON UNLESS CONFIRMED BY SITE INVESTIGATION.

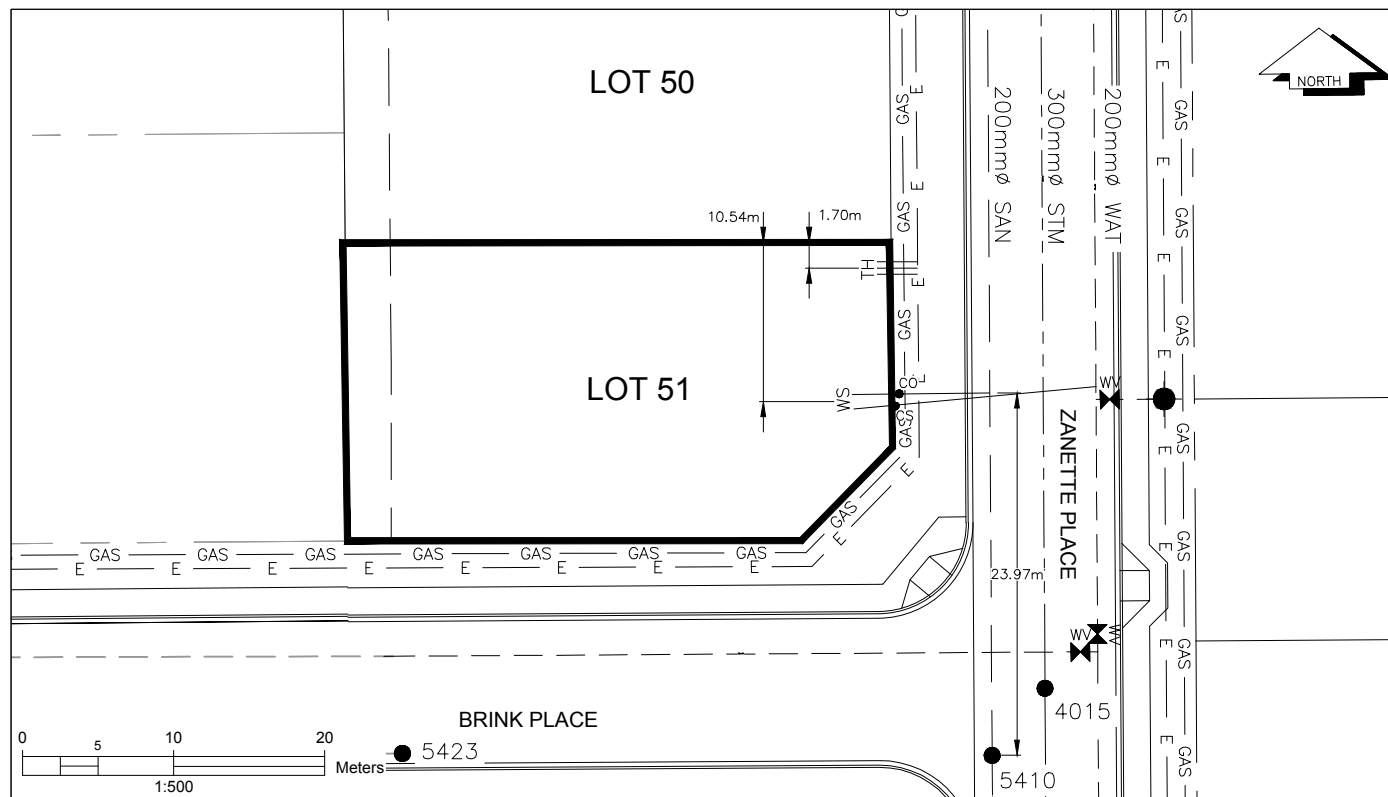

LEGEND:	CS CURB STOP	W WATER SERVICE	HYDRO SERVICE	GAS GAS
	CO CLEAN OUT	S SANITARY SERVICE	TELECOMMUNICATIONS	E ELECTRICAL