



City of Prince George History Sheet

PID:	014200520
	030014841
SD/MU:	
WO:	

Civic Address: 1442 McCullagh Ave

Lot: 9 Block: 2 District Lot: 934 Plan: 701

Legal Description: Lot: PCL A Block: 2 (CA5659370) District Lot: 934 Plan: 701


Service Type	Diameter (mm)	Material	Invert Elev at main (m)	Invert Elev at property line (m)	Invert Depth at service end (m)	Distance into property (m)	Installation Date
Sanitary (S1)	100mm	AC	566.23	566.73	2.35	-	January 1978
Sanitary (S2)	100mm	PVC	-	-	-	-	January 1978
Sanitary (S3)	100mm	AC	-	-	2.40	-	January 1978
Water (W1)	20mm	Copper	-	-	-	-	January 1978
Water (W2)	20mm	Copper	-	-	-	-	January 1978
Water (W3)	20mm	Copper	-	-	-	-	January 1978
Storm	N/A	N/A	-	-	-	-	

Service Connection Location				Sanitary (m)	Storm (m)
Distance from downstream San MH	1084	towards upstream San MH	1086	37.85	
Distance from downstream San MH	1084	towards upstream San MH	1086	52.11	
Distance from downstream San MH	1084	towards upstream San MH	1086	70.41	
Distance from downstream Stm MH	-	towards upstream Stm MH	-		

Power	Size	Communications	Size	Cable	Size	Gas	Size
BC Hydro	-	Telus	-	Shaw	-	FortisBC	-
Overhead Service		Overhead Service		Overhead Service			

Installed by:	Survey Date:	-
Comments:		

NOT TO SCALE The information contained herein is for internal use only.
Not to be relied on unless confirmed by site inspection and/or investigation.

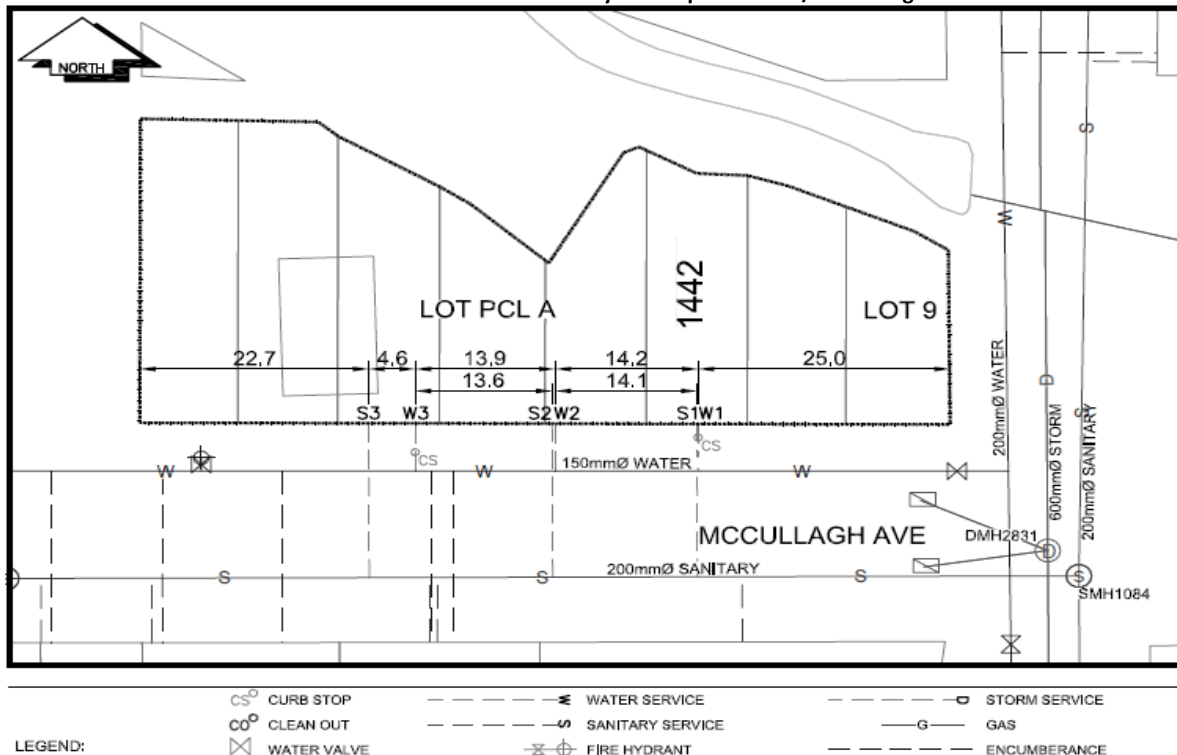

NOT TO SCALE