

Legal Description: Lot: A District Lot: 2433 Plan: EPP64503


Service Type	Diameter (mm)	Material	Invert Elev at main (m)	Invert Elev at property line (m)	Invert Elev at service end (m)	Distance into property (m)	Installation Date
Sanitary	100mm	PVC	734.89	735.02	735.02	-	October 2015
Water	20mm	Copper	733.99	734.84	734.87	-	October 2015
Storm	N/A	N/A	-	-	-	-	









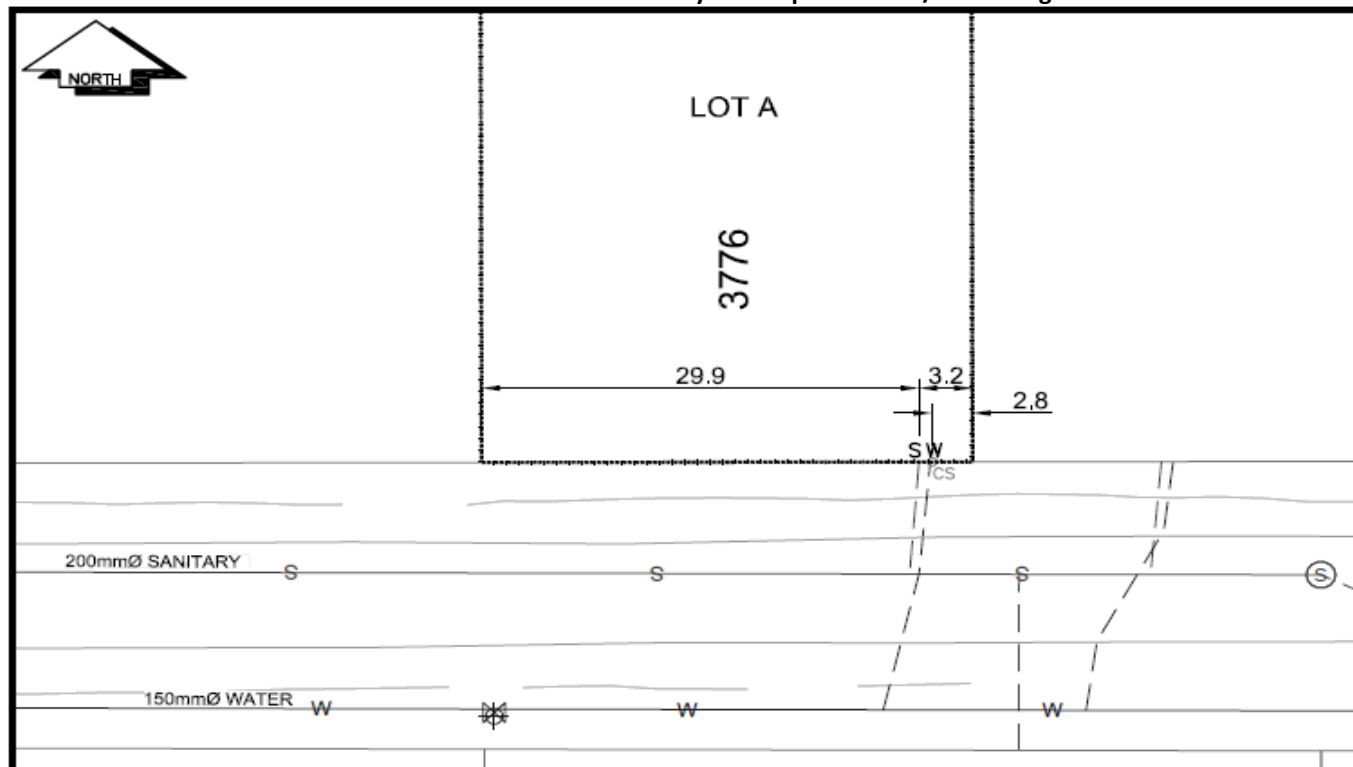




Power	Size	Communications	Size	Cable	Size	Gas	Size
BC Hydro	-	Telus	-	Shaw	-	FortisBC	-
Overhead Service		Overhead Service		Overhead Service			

Installed by:	City of Prince George forces
---------------	------------------------------

Comments:

NOT TO SCALE The information contained herein is for internal use only.
Not to be relied on unless confirmed by site inspection and/or investigation.



LEGEND:		CURB STOP			WATER SERVICE			STORM SERVICE
		CLEAN OUT			SANITARY SERVICE			GAS
		WATER VALVE			FIRE HYDRANT			ENCUMBRANCE

NOT TO SCALE