



City of Prince George History Sheet

PID:	030031095
MU:	101627
WO:	84213/84215

Civic Address: 3754 Chestnut Dr

Legal Description: Lot: B District Lot: 2433 Plan: EPP64503


Service Type	Diameter (mm)	Material	Invert Elev at main (m)	Invert Elev at property line (m)	Invert Elev at service end (m)	Distance into property (m)	Installation Date
Sanitary	100mm	PVC	734.97	735.77	735.77	0.50	October 2015
Water	20mm	Copper	734.27	734.45	734.45	0.50	October 2015
Storm	N/A	N/A	-	-	-	-	

Service Connection Location				Sanitary (m)	Storm (m)
Distance from downstream San MH	124	towards upstream San MH	125	104.00	
Distance from downstream Stm MH	-	towards upstream Stm MH	-		

Power	Size	Communications	Size	Cable	Size	Gas	Size
BC Hydro	-	Telus	-	Shaw	-	FortisBC	-
Overhead Service		Overhead Service		Overhead Service			

Installed by:	City of Prince George forces	Survey Date:	-
Comments:			

NOT TO SCALE The information contained herein is for internal use only.
Not to be relied on unless confirmed by site inspection and/or investigation.

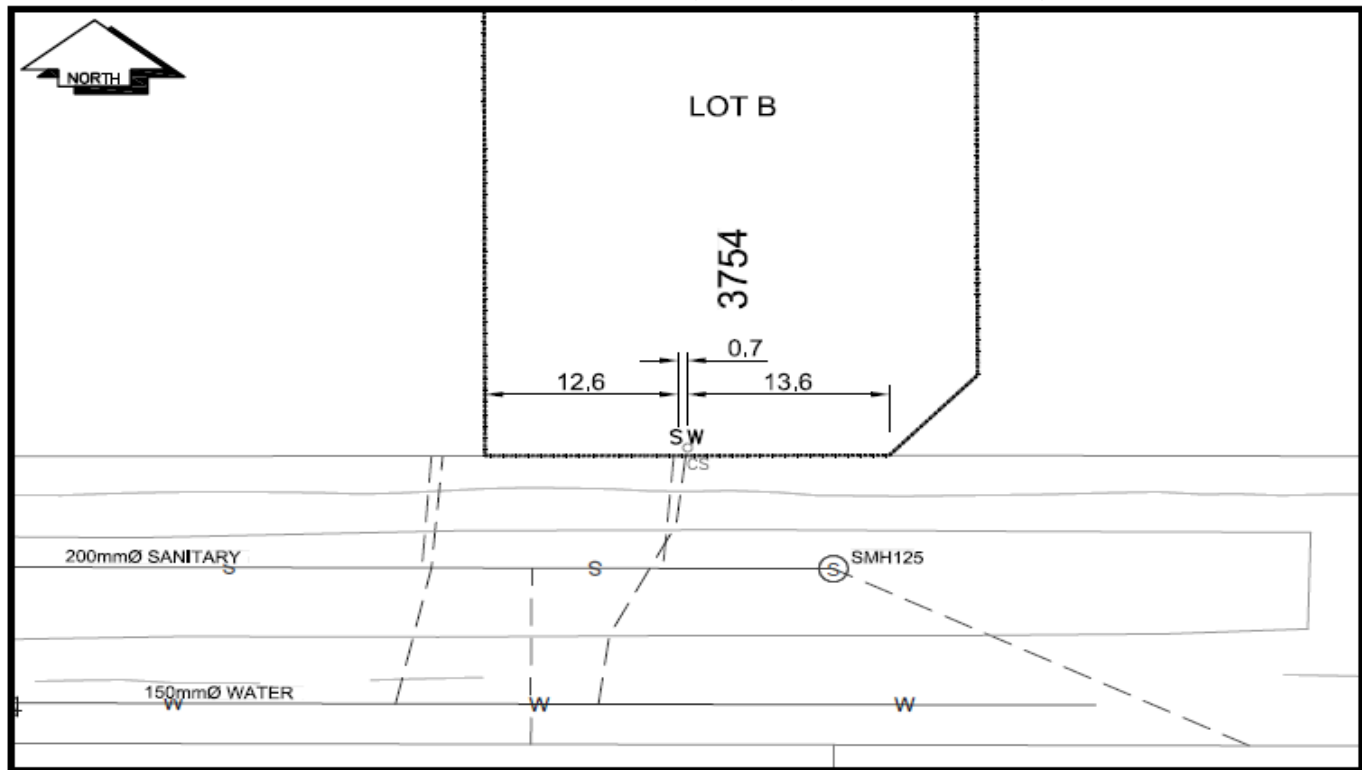

CS ^o CURB STOP	--- -- -- -- -- WATER SERVICE	--- -- -- -- -- STORM SERVICE
CO ^o CLEAN OUT	--- -- -- -- -- SANITARY SERVICE	--- G --- GAS
⊗ WATER VALVE	⊗ FIRE HYDRANT	--- -- -- -- -- ENCUMBRANCE

NOT TO SCALE