



City of Prince George History Sheet

PID:	030032091
SD/MU:	
WO:	

Civic Address: 2425 Laurier Cres

Legal Description: Lot: PCL C (CA5720812) Block: 114 District Lot: 343 Plan: 1268


Service Type	Diameter (mm)	Material	Invert Elev at main (m)	Invert Elev at property line (m)	Invert Depth at service end (m)	Distance into property (m)	Installation Date
Sanitary	100mm	AC	-	586.31	2.52	-	January 1957
Water	20mm	Copper	-	-	-	-	January 1957
Storm	N/A	N/A	-	-	-	-	

Service Connection Location				Sanitary (m)	Storm (m)
Distance from downstream San MH	3076	towards upstream San MH	3073	90.46	
Distance from downstream Stm MH	-	towards upstream Stm MH	-		

Power	Size	Communications	Size	Cable	Size	Gas	Size
BC Hydro	-	Telus	-	Shaw	-	FortisBC	-
Overhead Service		Overhead Service		Overhead Service			

Installed by:	Survey Date:	-
Comments:		

NOT TO SCALE The information contained herein is for internal use only.
Not to be relied on unless confirmed by site inspection and/or investigation.

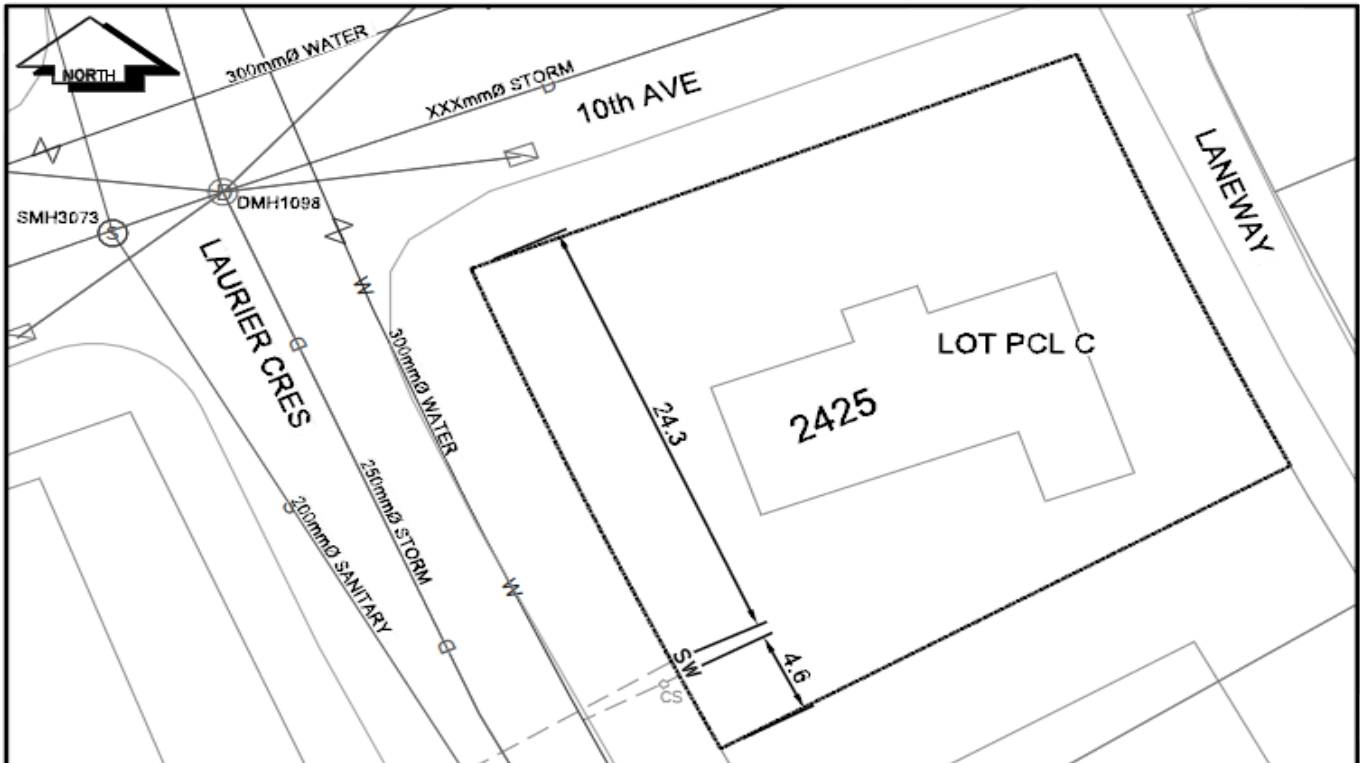

CS CURB STOP	--- W WATER SERVICE	--- S STORM SERVICE
CO CLEAN OUT	--- S SANITARY SERVICE	--- G GAS
WV WATER VALVE	--- FH FIRE HYDRANT	--- E ENCUMBERANCE

NOT TO SCALE