



City of Prince George History Sheet

PID:	030080703
SD/MU:	
WO:	

Civic Address: 1780 Boundary Rd

Legal Description: Lot: A District Lot: 629 Plan: EPP64502 except Plan EPP79589


Service Type	Diameter (mm)	Material	Invert Elev at main (m)	Invert Elev at property line (m)	Invert Elev at service end (m)	Distance into property (m)	Installation Date
Sanitary	Unknown	PVC	-	-	-	-	January 1976
Water	25mm	Copper	-	-	-	-	January 1981
Storm	N/A	N/A	-	-	-	-	

Service Connection Location				Sanitary (m)	Storm (m)
Distance from downstream San MH	3419	towards upstream San MH	3417	46.91	
Distance from downstream Stm MH	-	towards upstream Stm MH	-		

Power	Size	Communications	Size	Cable	Size	Gas	Size
BC Hydro	-	Telus	-	Shaw	-	FortisBC	-
Overhead Service		Overhead Service		Overhead Service			

Installed by:		Survey Date:	-
Comments:	Sanitary service as per John Handler - Jan 31, 2018		

NOT TO SCALE The information contained herein is for internal use only.
Not to be relied on unless confirmed by site inspection and/or investigation.

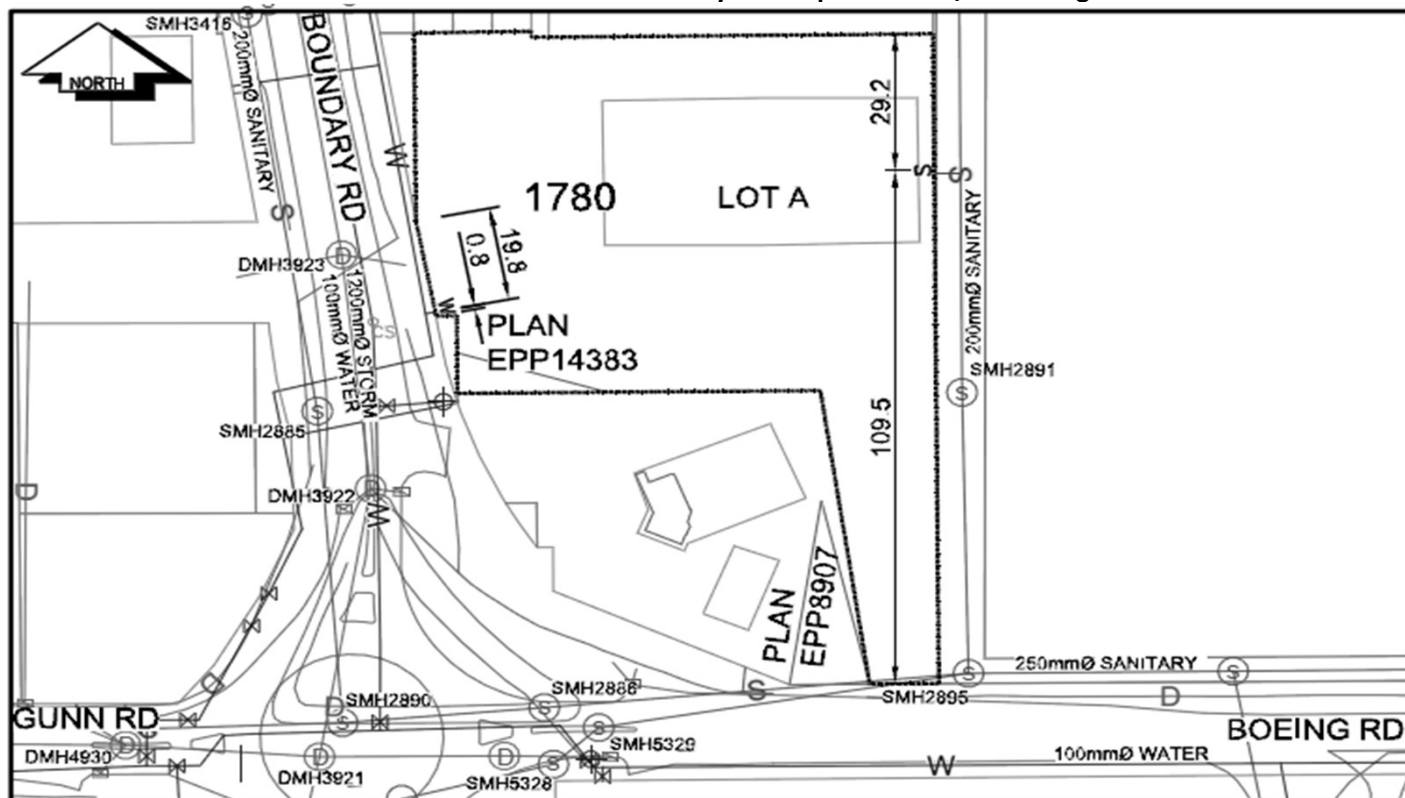

CS° CURB STOP	W WATER SERVICE	○ STORM SERVICE
CO° CLEAN OUT	- - - - S SANITARY SERVICE	- G - GAS
⊗ WATER VALVE	⊗ FIRE HYDRANT	- - - - ENCUMBRANCE

NOT TO SCALE