

City of Prince George

HISTORY SHEET

PID: 030-094-526

Scale: 1:2000

Legal: LOT 6

D.L.: 4039

PLAN: EPP56988

Address: 6222 MONTEREY ROAD

Sanitary Connection:#	SIZE: 150mmØ	MATERIAL: PVC	INV. 693.76m	CONNECTED
-----------------------	--------------	---------------	--------------	-----------

Water Connection:#	SIZE: 150mmØ	MATERIAL: PVC	INV. 693.19m	CONNECTED
--------------------	--------------	---------------	--------------	-----------

Storm Connection:#	SIZE 250mmØ	MATERIAL PVC	INV. 693.76m	CONNECTED
--------------------	-------------	--------------	--------------	-----------

Cash Receipt No's:	WATER	SANITARY	STORM
--------------------	-------	----------	-------

CURB FROM PROPERTY LINE	6m	PAVEMENT WIDTH	13m
-------------------------	----	----------------	-----

HYDRO	75mm DB2	U/G CONNECTION	✓
-------	----------	----------------	---

TELEPHONE	100mm DB2	U/G CONNECTION	✓
-----------	-----------	----------------	---


GAS	42 PROP/P.E.		
-----	--------------	--	--

Information Sheets: REF. DWGS. L&M ENGINEERING LTD. JOB 1146-09 DWGS

Comments:	SDW WATER SERVICE SDW STORM SERVICE SDW SANITARY SERVICE	CH HYDRO SERVICE CH CABLE SERVICE CH TELECOMMUNICATIONS	GAS GAS E ELECTRICAL
-----------	--	---	-------------------------

THE INFORMATION CONTAINED HEREIN IS FOR INTERNAL USE ONLY.

NOT TO BE RELIED UPON UNLESS CONFIRMED BY THE SITE INSPECTION AND/OR INVESTIGATION

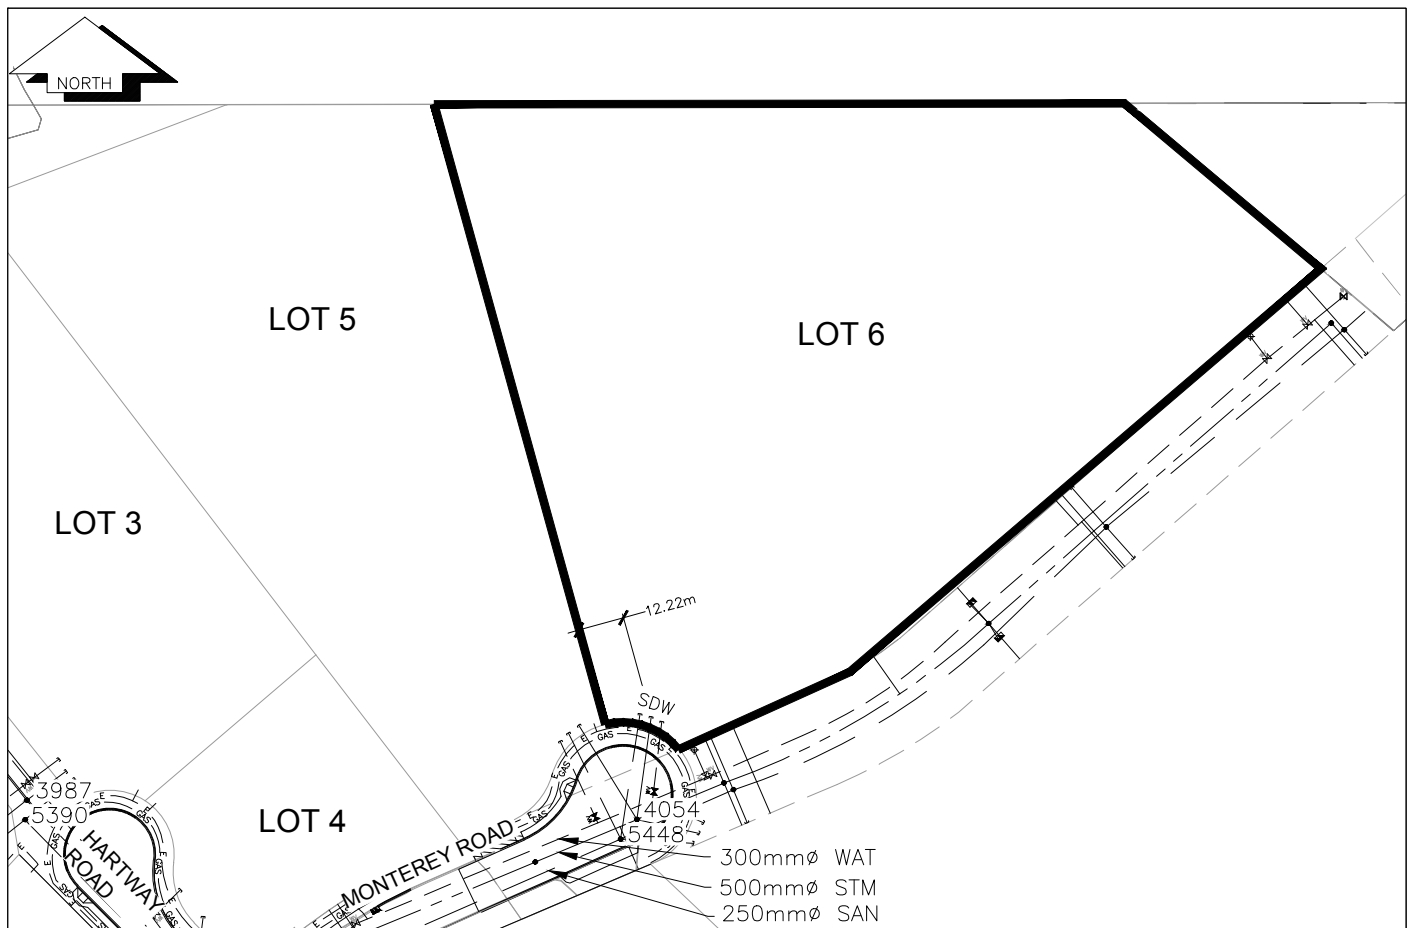

SANITARY, STORM & WATER SERVICE INVERTS	SANITARY	WATER	STORM
1. Distance from San. M.H. <u>5448</u> toward San. M.H. <u> </u> - <u> </u> to lot service connection point is:	0m	N/A	N/A
1a.Distance from Stm. M.H. <u>4054</u> toward Stm. M.H. <u> </u> - <u> </u> to lot service connection point is:	N/A	N/A	0m
2. Main Size at connection point is	250mmØ	300mmØ	600mmØ
3. Invert of main at conn. stub point is	692.34m	692.78m	693.25m
4. Invert at service end is	693.90m	693.26m	693.82m
5. Cover at property line in meters	2.68m	3.25m	2.58m
6. Survey Date:OCT 2015 Book Ref.:1146-09 By:L&M ENGINEERING LTD			

SANITARY HISTORY:

DATE INSTALLED: JULY 2015

INSTALLED BY: JOE ROBERTS CONSTRUCTION

WATER HISTORY:

DATE INSTALLED: JULY 2015

INSTALLED BY: JOE ROBERTS CONSTRUCTION

STORM HISTORY:

DATE INSTALLED: JULY 2015

INSTALLED BY: JOE ROBERTS CONSTRUCTION