

City of Prince George

HISTORY SHEET

PID: 030-094-551

Scale: 1:1000

Legal: LOT 4

D.L.: 4039

PLAN: EPP56988

Address: 5538 HARTWAY DRIVE

Sanitary Connection:#	SIZE: 150mmØ	MATERIAL: PVC	INV. -	CONNECTED
-----------------------	--------------	---------------	--------	-----------

Water Connection:#	SIZE: 150mmØ	MATERIAL: PVC	INV. 694.11m	CONNECTED
--------------------	--------------	---------------	--------------	-----------

Storm Connection:#	SIZE 250mmØ	MATERIAL PVC	INV. 693.40m	CONNECTED
--------------------	-------------	--------------	--------------	-----------

Cash Receipt No's:	WATER	SANITARY	STORM
--------------------	-------	----------	-------

CURB FROM PROPERTY LINE	5m	PAVEMENT WIDTH	10m
-------------------------	----	----------------	-----

HYDRO	75mm DB2	U/G CONNECTION	✓
-------	----------	----------------	---


TELEPHONE	100mm DB2	U/G CONNECTION	✓
-----------	-----------	----------------	---

GAS	42 PROP/P.E.		
-----	--------------	--	--

Information Sheets: REF. DWGS. L&M ENGINEERING LTD. JOB 1146-09 DWGS

Comments:	SDW WATER SERVICE STORM SERVICE SANITARY SERVICE	TCH HYDRO SERVICE CABLE SERVICE TELECOMMUNICATIONS	GAS GAS E ELECTRICAL
-----------	--	--	-------------------------

THE INFORMATION CONTAINED HEREIN IS FOR INTERNAL USE ONLY.
NOT TO BE RELIED UPON UNLESS CONFIRMED BY THE SITE INSPECTION AND/OR INVESTIGATION

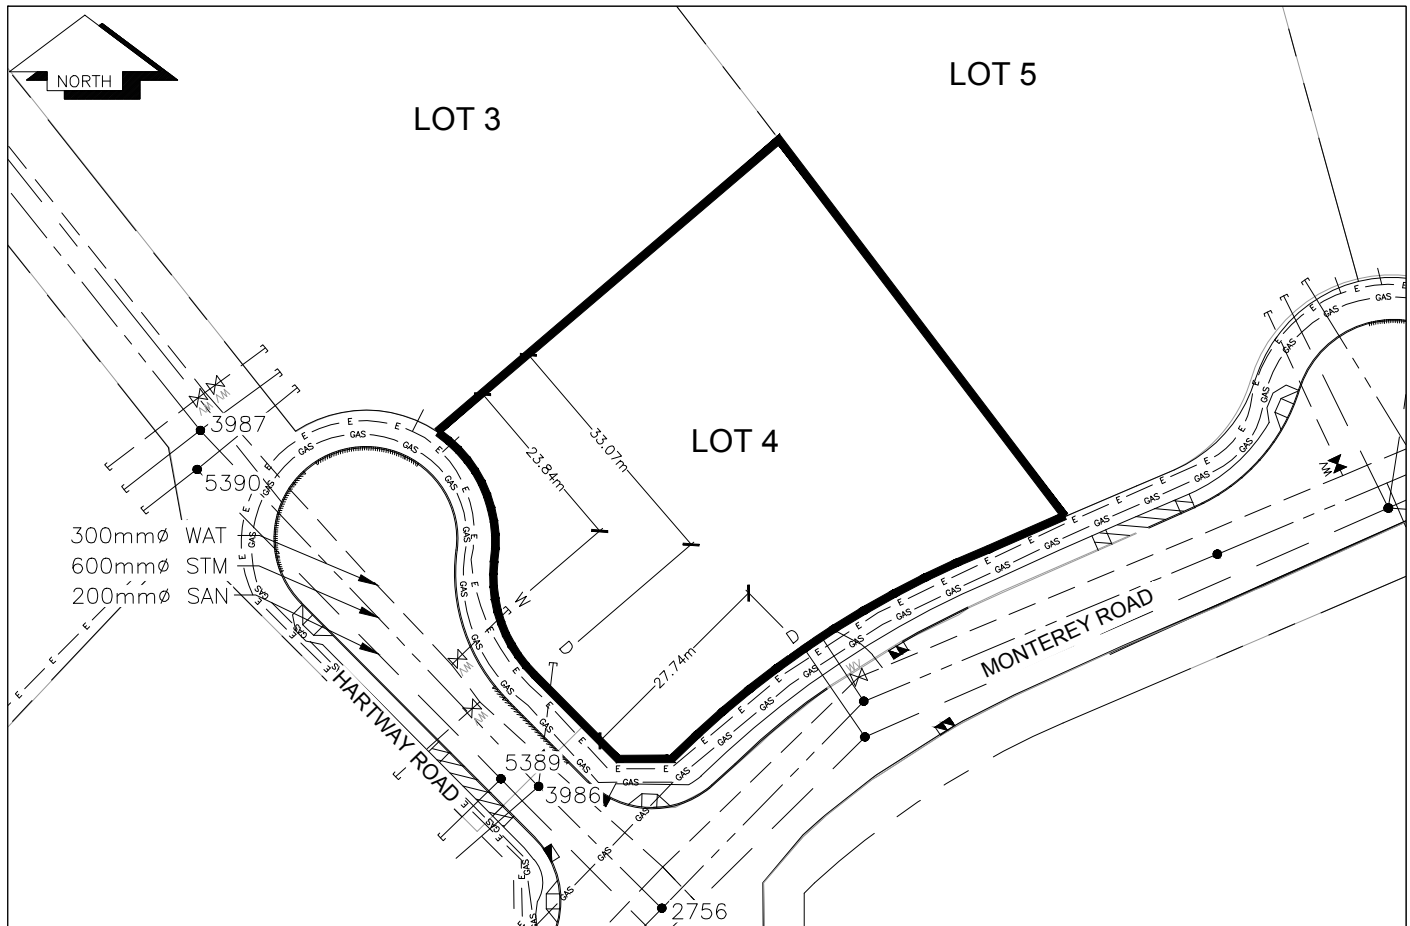

SANITARY, STORM & WATER SERVICE INVERTS	SANITARY	WATER	STORM
1. Distance from San. M.H. <u> N/A </u> toward San. M.H. <u> N/A </u> to lot service connection point is:	N/A	N/A	N/A
1a.Distance from Stm. M.H. <u> 3986 </u> toward Stm. M.H. <u> 2756 </u> to lot service connection point is:	N/A	N/A	0m
2. Main Size at connection point is	N/A	150mmØ	250mmØ
3. Invert of main at conn. stub point is	N/A	692.30m	693.10m
4. Invert at service end is	N/A	694.54m	693.40m
5. Cover at property line in meters	N/A	3.01m	2.53m
6. Survey Date:OCT 2015 Book Ref.:1146-09 By:L&M ENGINEERING LTD			

SANITARY HISTORY:

DATE INSTALLED: JULY 2015

INSTALLED BY: JOE ROBERTS CONSTRUCTION

WATER HISTORY:

DATE INSTALLED: JULY 2015

INSTALLED BY: JOE ROBERTS CONSTRUCTION

STORM HISTORY:

DATE INSTALLED: JULY 2015

INSTALLED BY: JOE ROBERTS CONSTRUCTION