

City of Prince George

HISTORY SHEET

PID: 030-094-569

Scale: 1:2000

Legal: LOT 5

D.L.: 4039

PLAN: EPP56988

Address: 6116 MONTEREY ROAD

Sanitary Connection:#	SIZE: 150mmØ	MATERIAL: PVC	INV. 693.58m	CONNECTED
-----------------------	--------------	---------------	--------------	-----------

Water Connection:#	SIZE: 150mmØ	MATERIAL: PVC	INV. 693.41m	CONNECTED
--------------------	--------------	---------------	--------------	-----------

Storm Connection:#	SIZE: 250mmØ	MATERIAL: PVC	INV. 693.80m	CONNECTED
--------------------	--------------	---------------	--------------	-----------

Cash Receipt No's:	WATER	SANITARY	STORM
--------------------	-------	----------	-------

CURB FROM PROPERTY LINE	6m	PAVEMENT WIDTH	13m
-------------------------	----	----------------	-----

HYDRO	75mm DB2	U/G CONNECTION	✓
-------	----------	----------------	---


TELEPHONE	100mm DB2	U/G CONNECTION	✓
-----------	-----------	----------------	---

GAS	42 PROP/P.E.		
-----	--------------	--	--

Information Sheets: REF. DWGS. L&M ENGINEERING LTD. JOB 1146-09 DWGS

Comments:	SDW WATER SERVICE STORM SERVICE SANITARY SERVICE	TCH HYDRO SERVICE CABLE SERVICE TELECOMMUNICATIONS	GAS GAS E ELECTRICAL
-----------	--	--	-------------------------

THE INFORMATION CONTAINED HEREIN IS FOR INTERNAL USE ONLY.
NOT TO BE RELIED UPON UNLESS CONFIRMED BY THE SITE INSPECTION AND/OR INVESTIGATION

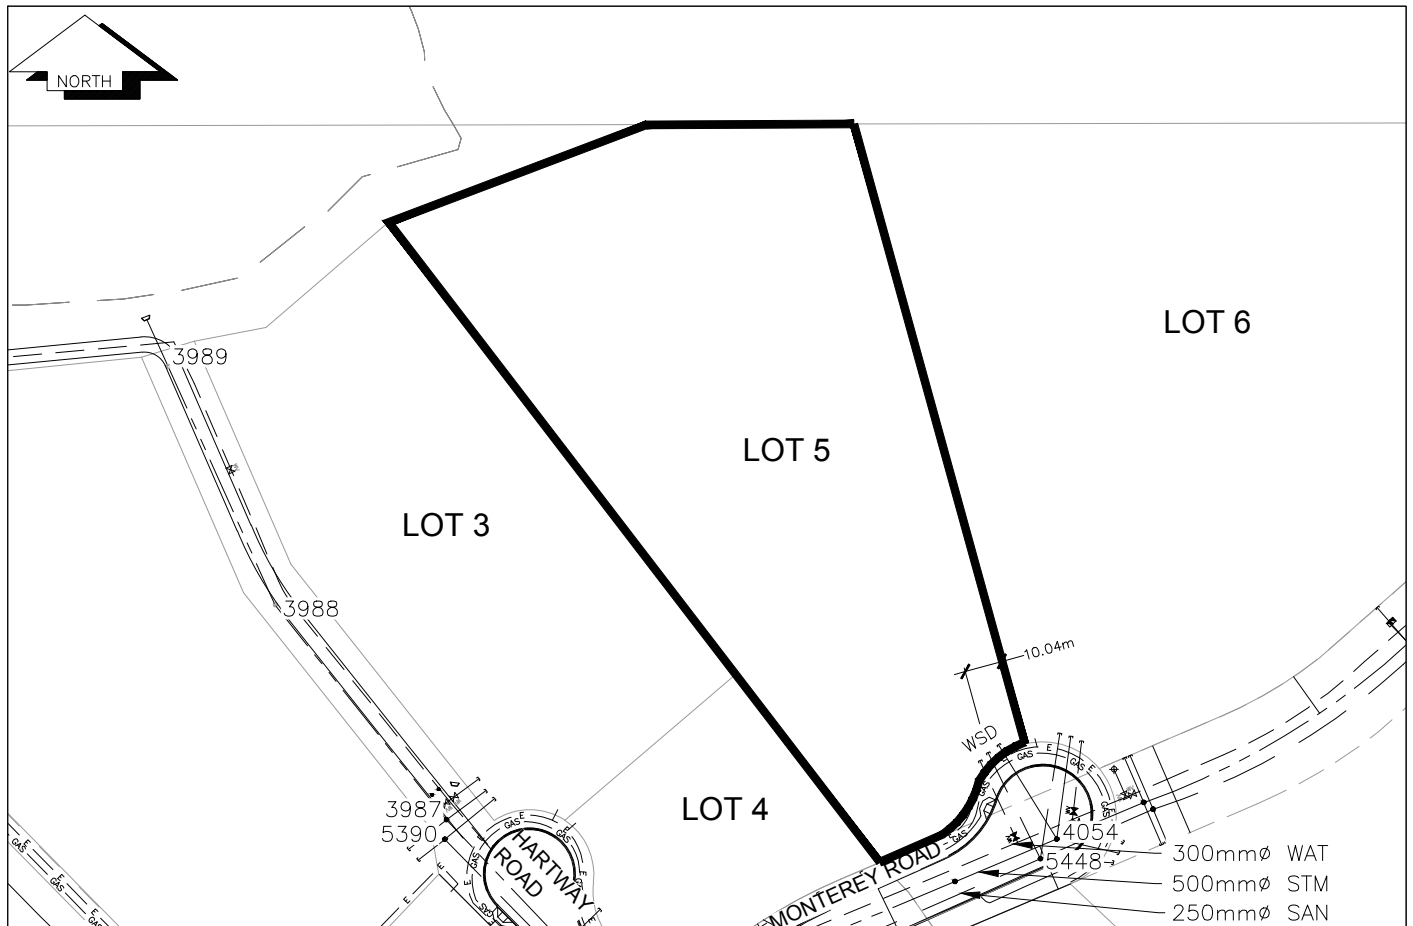

SANITARY, STORM & WATER SERVICE INVERTS	SANITARY	WATER	STORM
1. Distance from San. M.H. <u>5448</u> toward San. M.H. <u> </u> - <u> </u> to lot service connection point is:	0m	N/A	N/A
1a.Distance from Stm. M.H. <u>4054</u> toward Stm. M.H. <u> </u> - <u> </u> to lot service connection point is:	N/A	N/A	0m
2. Main Size at connection point is	250mmØ	300mmØ	500mmØ
3. Invert of main at conn. stub point is	692.34m	693.41m	693.25m
4. Invert at service end is	693.71m	693.51m	693.86m
5. Cover at property line in meters	2.78m	3.10m	2.46m
6. Survey Date:OCT 2015 Book Ref.:1146-09 By:L&M ENGINEERING LTD			

SANITARY HISTORY:

DATE INSTALLED: JULY 2015

INSTALLED BY: JOE ROBERTS CONSTRUCTION

WATER HISTORY:

DATE INSTALLED: JULY 2015

INSTALLED BY: JOE ROBERTS CONSTRUCTION

STORM HISTORY:

DATE INSTALLED: JULY 2015

INSTALLED BY: JOE ROBERTS CONSTRUCTION