



# City of Prince George History Sheet

PID:	030143276
SD/MU:	
WO:	

Civic Address: 2646 Kaslo St

Legal Description: Lot: PCL B (CA6020115) Block: 19 District Lot: 933 Plan: 727


Service Type	Diameter (mm)	Material	Invert Elev at main (m)	Invert Elev at property line (m)	Invert Elev at service end (m)	Distance into property (m)	Installation Date
Sanitary	100mm	AC	-	-	-	-	January 1971
Water	20mm	Copper	-	-	-	-	January 1955
Storm	N/A	N/A	-	-	-	-	

Service Connection Location				Sanitary (m)	Storm (m)
Distance from downstream San MH	3531	towards upstream San MH	3554	20.16	
Distance from downstream Stm MH	-	towards upstream Stm MH	-		

Power	Size	Communications	Size	Cable	Size	Gas	Size
BC Hydro	-	Telus	-	Shaw	-	FortisBC	-
Overhead Service		Overhead Service		Overhead Service			

Installed by:	Survey Date:	-
Comments: Water service confirmed August 23, 1985		

**NOT TO SCALE** The information contained herein is for internal use only.  
Not to be relied on unless confirmed by site inspection and/or investigation.

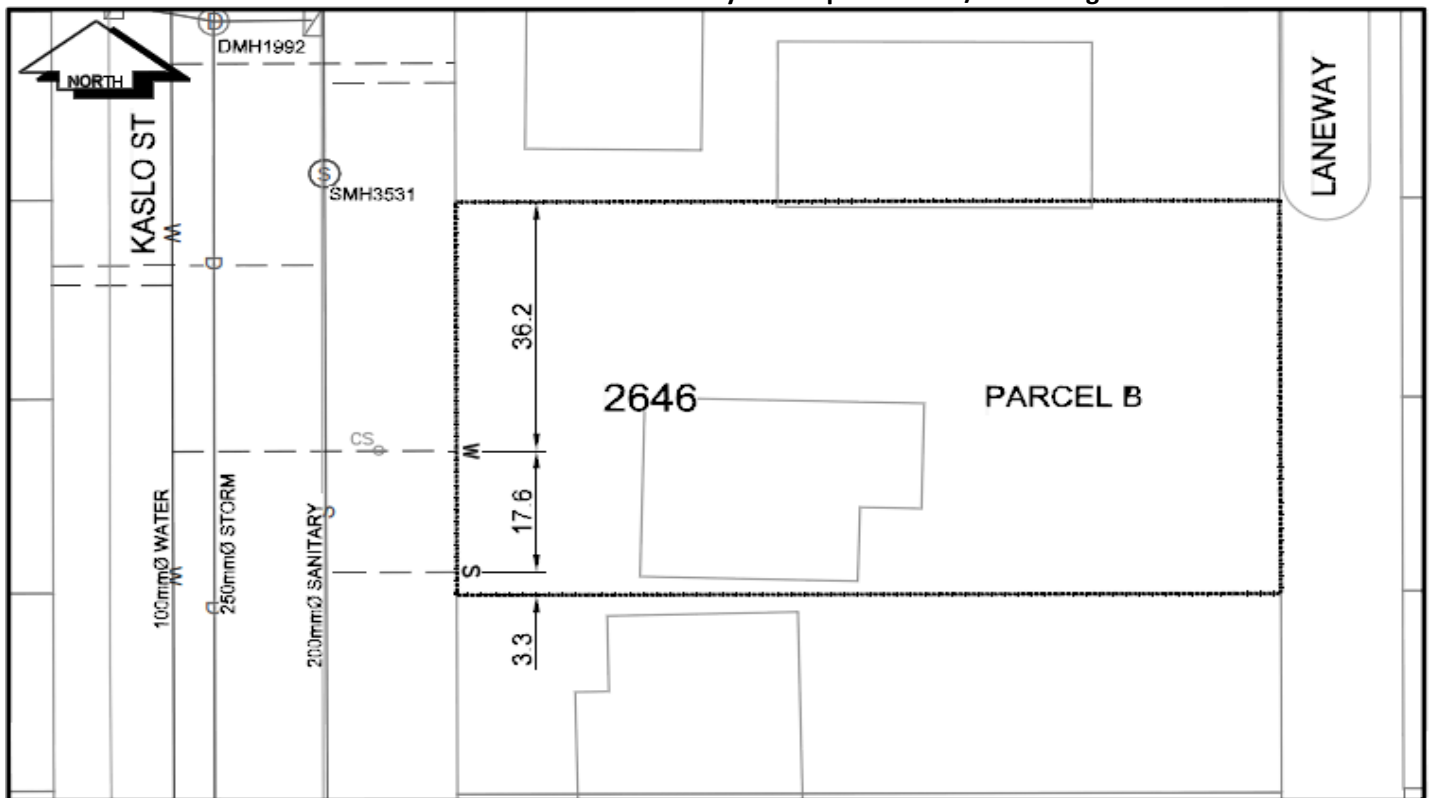

CS	CURB STOP	---	WATER SERVICE	---	STORM SERVICE
CO	CLEAN OUT	---	SANITARY SERVICE	---	GAS
V	WATER VALVE	---	FIRE HYDRANT	---	ENCUMBRANCE

**NOT TO SCALE**