



City of Prince George History Sheet

PID:	030164559
SD/MU:	
WO:	

Civic Address: 2731 Gunn Rd

Legal Description: Lot: PCL C (CA6065690) Block: 63 District Lot: 629 Plan: 902


Service Type	Diameter (mm)	Material	Invert Elev at main (m)	Invert Elev at property line (m)	Invert Elev at service end (m)	Distance into property (m)	Installation Date
Sanitary	100mm	PVC	-	-	-	-	January 1976
Water	Unknown	Unknown	-	-	-	-	
Storm	N/A	N/A	-	-	-	-	

Service Connection Location				Sanitary (m)	Storm (m)
Distance from downstream San MH	2884	towards upstream San MH	2883	29.05	
Distance from downstream Stm MH	-	towards upstream Stm MH	-		

Power	Size	Communications	Size	Cable	Size	Gas	Size
BC Hydro	-	Telus	-	Shaw	-	FortisBC	-
Overhead Service		Overhead Service		Overhead Service			

Installed by:	Survey Date:	-
Comments:		

NOT TO SCALE The information contained herein is for internal use only.
Not to be relied on unless confirmed by site inspection and/or investigation.

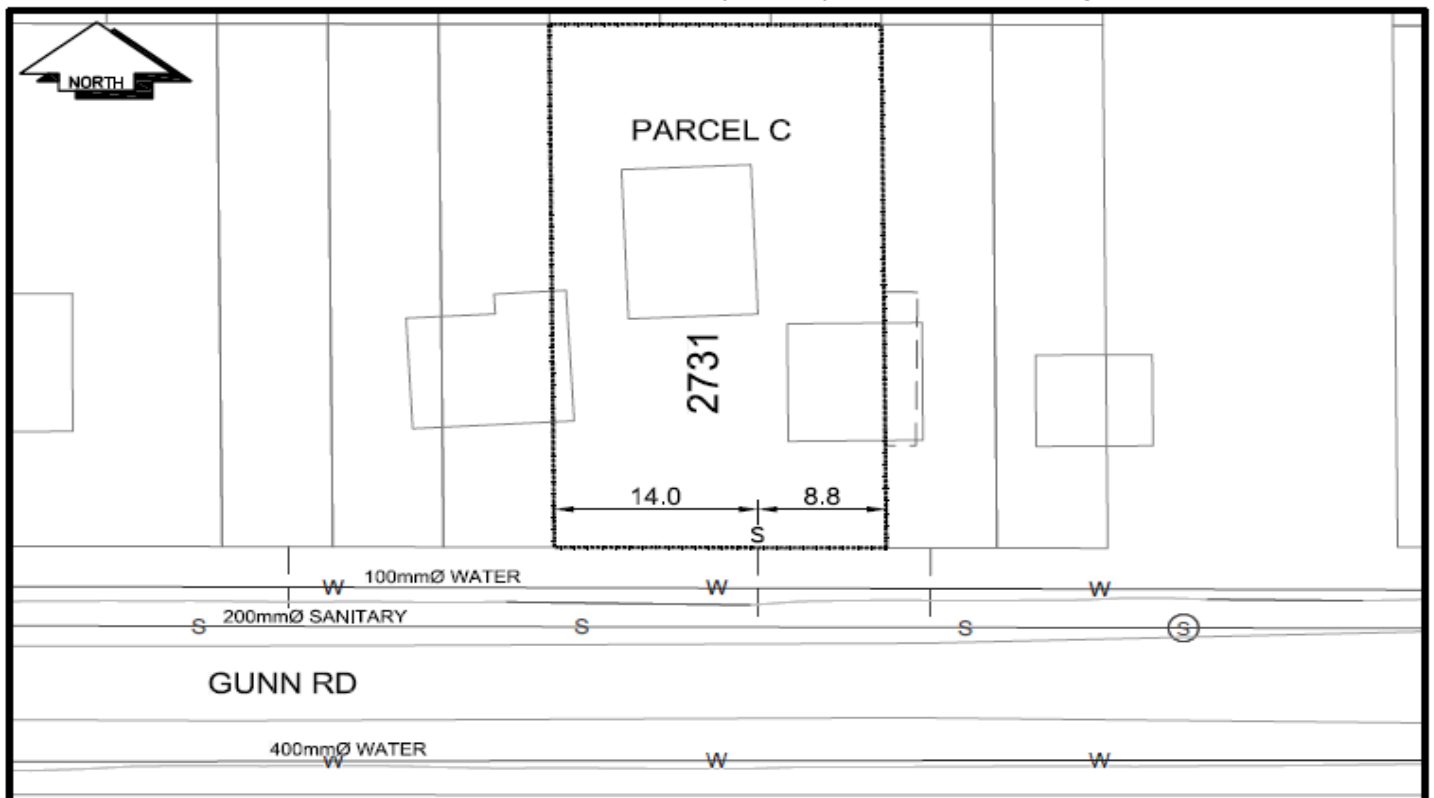

CS ^o CURB STOP	--- -- -- -- -- WATER SERVICE	--- -- -- -- -- S STORM SERVICE
CO ^o CLEAN OUT	--- -- -- -- -- S SANITARY SERVICE	--- G --- GAS
X WATER VALVE	⊗ FIRE HYDRANT	--- -- -- -- -- ENCUMBRANCE

NOT TO SCALE