



City of Prince George

History Sheet

PID:	013057219
	030191823
SD/MU:	
WO:	

Civic Address: 2217 Laurier Cres
2235 Laurier Cres

Legal Description: Lot: 23 Block: 120 District Lot: 343 Plan: 1268
Lot: PCL C Block: 120 District Lot: 343 Plan: 1268


Service Type	Diameter (mm)	Material	Invert Elev at main (m)	Invert Elev at property line (m)	Invert Depth at service end (m)	Distance into property (m)	Installation Date
Sanitary - PCL C	100mm	PVC	-	586.75	1.83	-	January 1957
Water - PCL C	20mm	Copper	-	-	-	-	January 1957
Storm	N/A	N/A	-	-	-	-	

Service Connection Location				Sanitary (m)	Storm (m)
Distance from downstream San MH	1979	towards upstream San MH	2679	33.79	
Distance from downstream Stm MH	-	towards upstream Stm MH	-		

Power	Size	Communications	Size	Cable	Size	Gas	Size
BC Hydro	-	Telus	-	Shaw	-	FortisBC	-
Overhead Service		Overhead Service		Overhead Service			

Installed by:	Survey Date:	-
Comments:		

NOT TO SCALE The information contained herein is for internal use only.
Not to be relied on unless confirmed by site inspection and/or investigation.

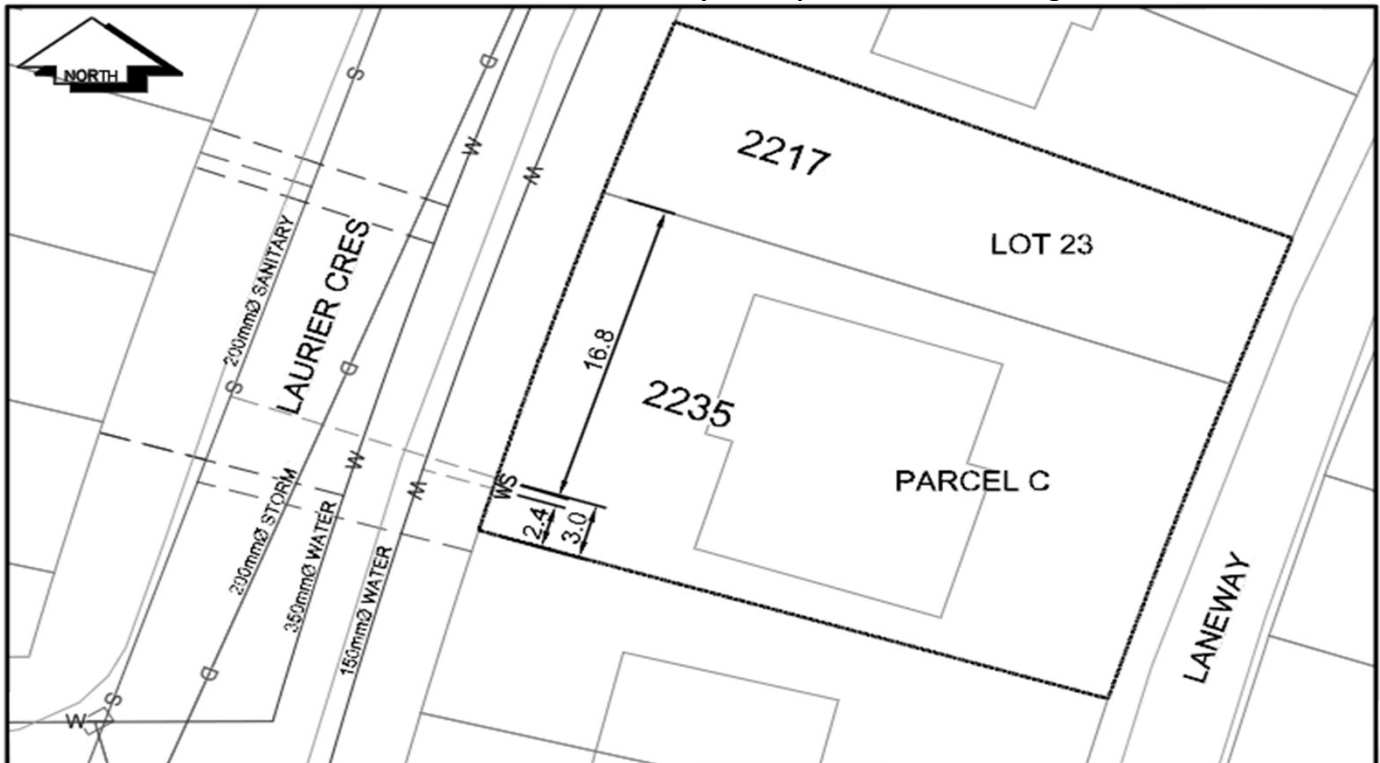

CS	CURB STOP	---	W	WATER SERVICE	---	○	STORM SERVICE
CO	CLEAN OUT	---	S	SANITARY SERVICE	---	G	GAS
⊗	WATER VALVE	---	⊕	FIRE HYDRANT	---	---	ENCUMBERANCE

NOT TO SCALE