



City of Prince George  
**History Sheet**

PID:	030241863
SD/MU:	
WO:	

Civic Address: 887 Gillette St

Legal Description: Lot: PCL C Block: 35 (CA6279443) District Lot: 1429 Plan: 646


Service Type	Diameter (mm)	Material	Invert Elev at main (m)	Invert Elev at property line (m)	Invert Depth at service end (m)	Distance into property (m)	Installation Date
Sanitary	100mm	AC		595.03	2.43		January 1960
Water	20mm	Copper	-	-	-	-	January 1960
Storm	N/A	N/A	-	-	-	-	

Service Connection Location				Sanitary (m)	Storm (m)
Distance from downstream San MH	3053	towards upstream San MH	1965	143.00	
Distance from downstream Stm MH	-	towards upstream Stm MH	-		

Power	Size	Communications	Size	Cable	Size	Gas	Size
BC Hydro	-	Telus	-	Shaw	-	FortisBC	-
Overhead Service		Overhead Service		Overhead Service			

Installed by:	Survey Date:	-
Comments:		

**NOT TO SCALE** The information contained herein is for internal use only.  
Not to be relied on unless confirmed by site inspection and/or investigation.

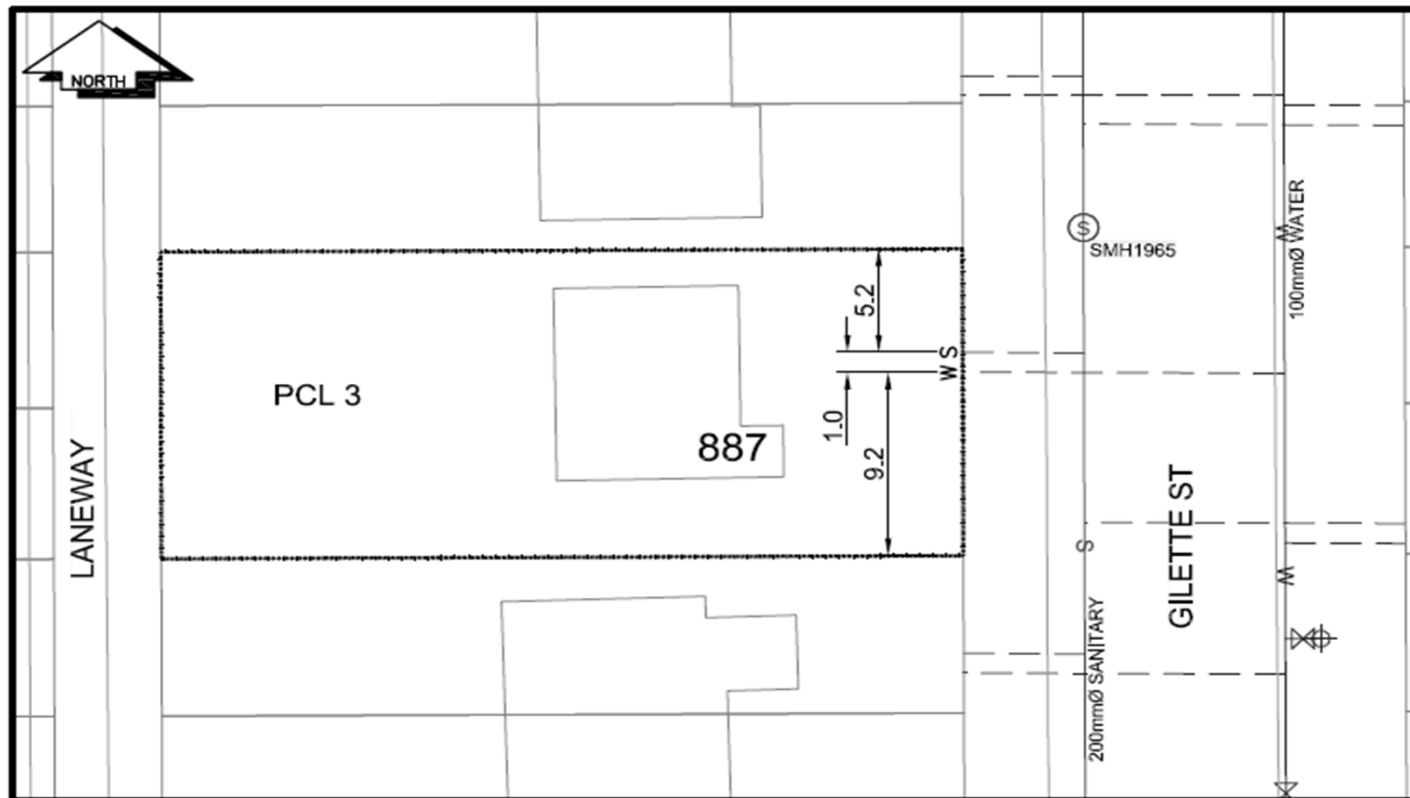

CS <sup>o</sup> CURB STOP	--- W --- WATER SERVICE	--- S --- STORM SERVICE
CO <sup>o</sup> CLEAN OUT	--- S --- SANITARY SERVICE	--- G --- GAS
WATER VALVE	--- F --- FIRE HYDRANT	--- E --- ENCUMBRANCE

**NOT TO SCALE**