



City of Prince George History Sheet

PID:	030263689
SD/MU:	
WO:	

Civic Address: 2772 Recplace Dr

Legal Description: Lot: 1 District Lot: 8180 Plan: EPP66494


Service Type	Diameter (mm)	Material	Invert Elev at main (m)	Invert Elev at property line (m)	Invert Elev at service end (m)	Distance into property (m)	Installation Date
Sanitary	150mm	PVC	-	-	-		March 2013
Water	200mm	PVC	-	-	-	-	March 2013
Storm	375mm	PVC	-	-	-	-	March 2013

Service Connection Location	Sanitary (m)	Storm (m)
150mm Sanitary service connected to San MH 5384	-	
300mm Storm service connected to Stm MH3978	-	

Power	Size	Communications	Size	Cable	Size	Gas	Size
BC Hydro	-	Telus	-	Shaw	-	FortisBC	-
Underground Service		Underground Service		Underground Service			

Installed by:	Survey Date:	-
Comments:		

NOT TO SCALE The information contained herein is for internal use only.
Not to be relied on unless confirmed by site inspection and/or investigation.

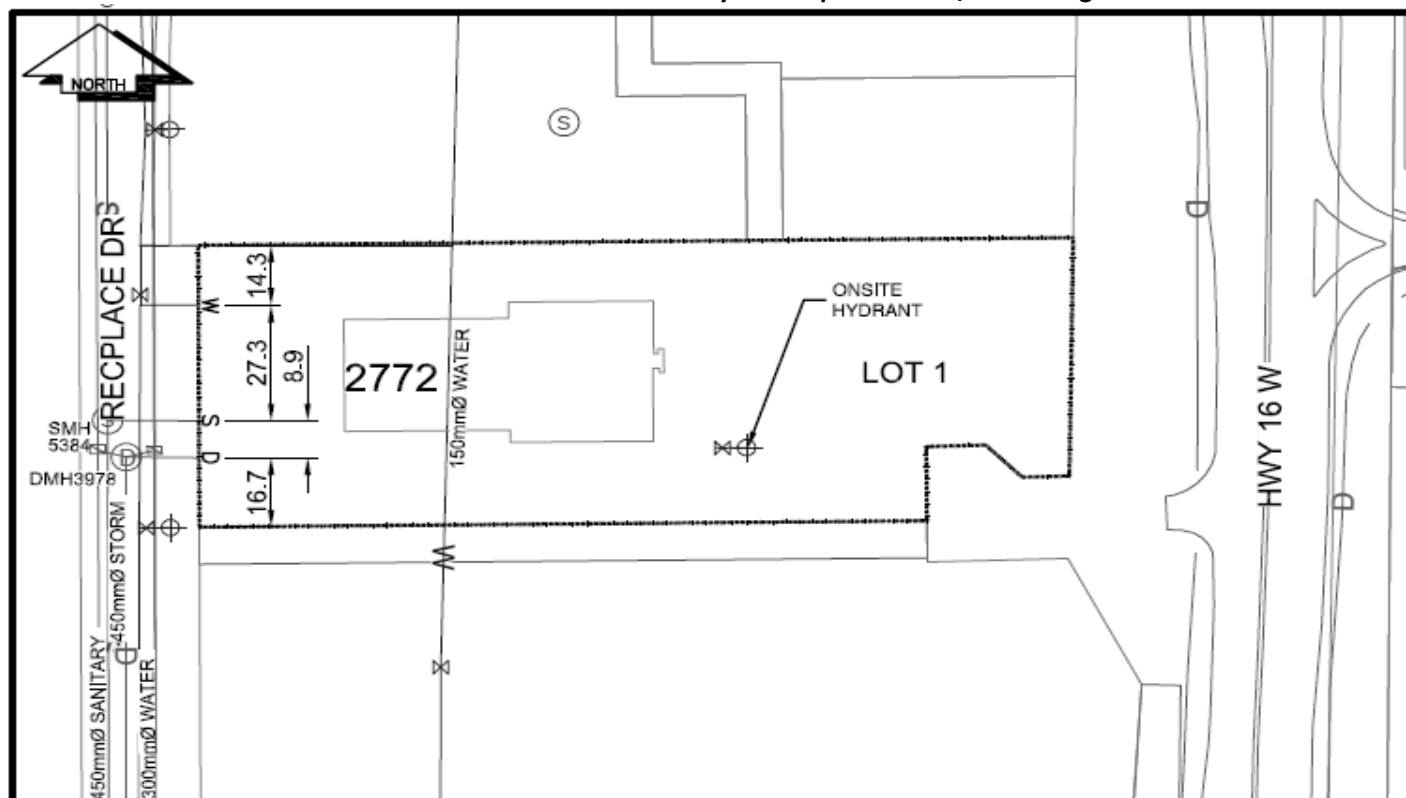

CS ^o CURB STOP	— W — WATER SERVICE	— S — STORM SERVICE
CO ^o CLEAN OUT	- - - S - SANITARY SERVICE	— G — GAS
⊗ WATER VALVE	⊗ FIRE HYDRANT	- - - - - ENCUMBRANCE

NOT TO SCALE