



City of Prince George History Sheet

PID:	030292492
SD/MU:	
WO:	

Civic Address: 2987 Vista Ridge Dr

Legal Description: Lot: 2 District Lot: 1605 Plan: EPP72162


Service Type	Diameter (mm)	Material	Invert Elev at main (m)	Invert Elev at property line (m)	Invert Depth at service end (m)	Distance into property (m)	Installation Date
Sanitary	100mm	PVC	663.23	664.11	2.29	-	July 2010
Water	20mm	Copper	663.26	664.09	2.57	-	July 2010
Storm	100mm	PVC	663.32	664.11	2.30	-	July 2010

Service Connection Location				Sanitary (m)	Storm (m)
Distance from downstream San MH	5150	towards upstream San MH	5151	0.00	
Distance from downstream Stm MH	3671	towards upstream Stm MH	3672		

Power	Size	Communications	Size	Cable	Size	Gas	Size
BC Hydro	75mm DB2	Telus	50mm DB2	Shaw	-	FortisBC	32 PROP/P.E
Underground Service		Underground Service		Underground Service			

Installed by:	Western Industrial Contractors Ltd	Survey Date:	-
Comments:			

NOT TO SCALE The information contained herein is for internal use only.
Not to be relied on unless confirmed by site inspection and/or investigation.

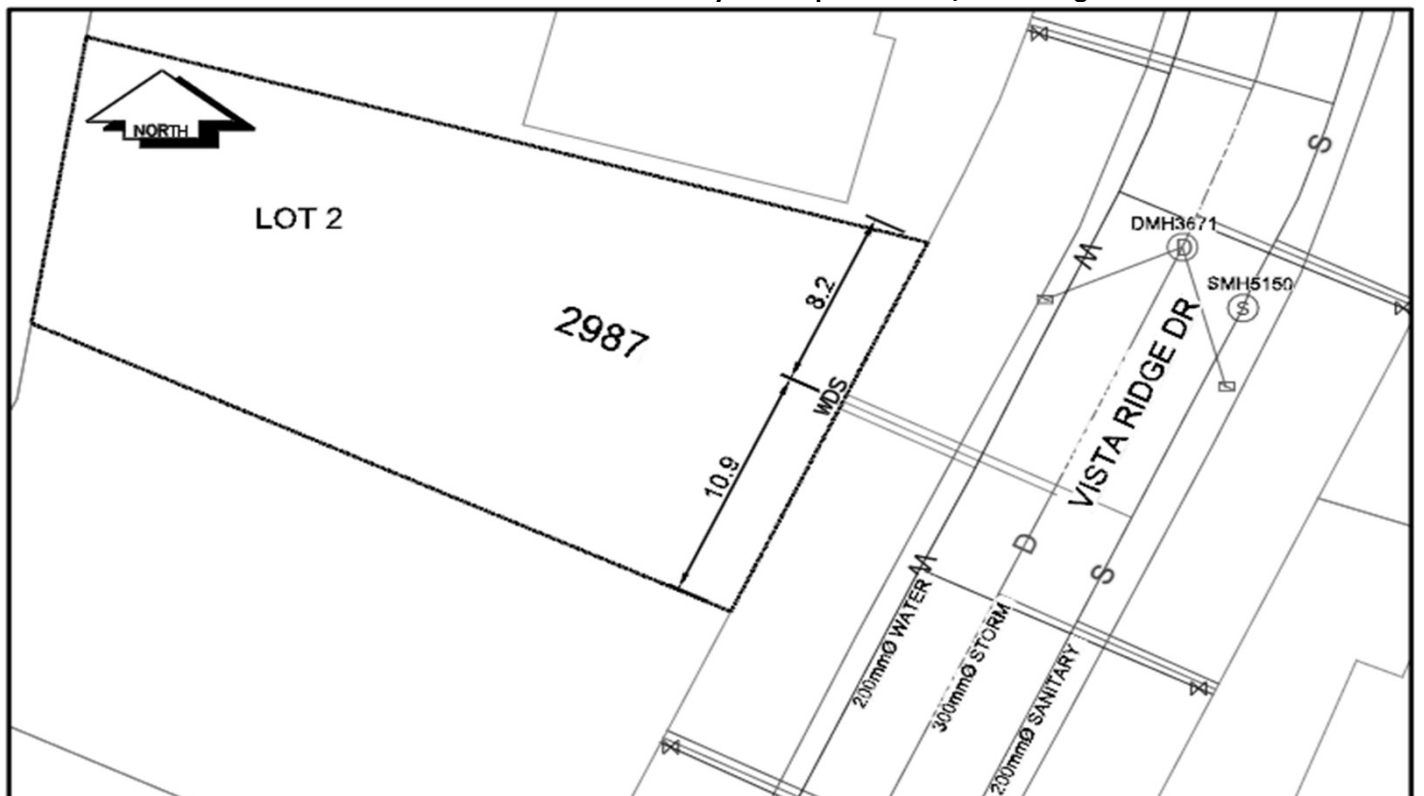

CS ^o CURB STOP	— W WATER SERVICE	— S STORM SERVICE
CO ^o CLEAN OUT	- - - - - SANITARY SERVICE	— G GAS
⊗ WATER VALVE	⊗ FIRE HYDRANT	- - - - - ENCUMBRANCE

NOT TO SCALE