



# City of Prince George History Sheet

PID:	030295556
SD/MU:	
WO:	

Civic Address: 2419 Queensway

Legal Description: Lot: District Lot: 417 Plan: EPP76889


Service Type	Diameter (mm)	Material	Invert Elev at main (m)	Invert Elev at property line (m)	Invert Elev at service end (m)	Distance into property (m)	Installation Date
Sanitary - north	100mm	AC	-	-	-	-	December 1980
Sanitary - south	100mm	AC	-	-	-	-	December 1980
Water - north	20mm	Copper	-	-	-	-	December 1954
Water - south	20mm	Copper	-	-	-	-	December 1954
Storm	200mm	PVC	-	-	-	-	December 1977

Service Connection Location				Sanitary (m)	Storm (m)
Distance from downstream San MH	1727	towards upstream San MH	1095	110.73	
Distance from downstream San MH	1095	towards upstream San MH	1101	18.03	
200mm Storm service connected to Stm MH3257					

Power	Size	Communications	Size	Cable	Size	Gas	Size
BC Hydro	-	Telus	-	Shaw	-	FortisBC	-
Overhead Service		Overhead Service		Overhead Service			

Installed by:	Survey Date:	-
Comments:		

**NOT TO SCALE** The information contained herein is for internal use only.  
Not to be relied on unless confirmed by site inspection and/or investigation.

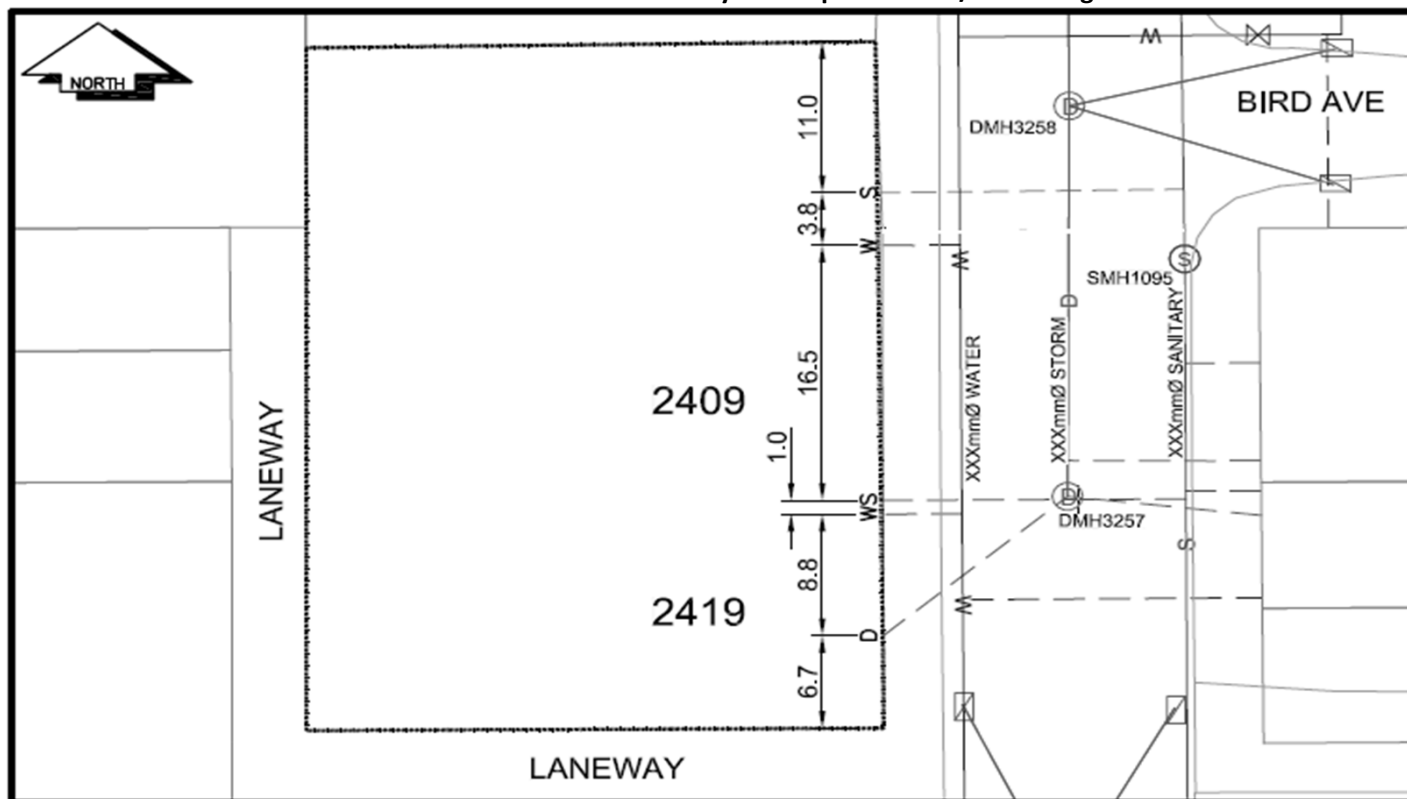

CS <sup>o</sup> CURB STOP	--- WATER SERVICE	--- STORM SERVICE
CO <sup>o</sup> CLEAN OUT	--- SANITARY SERVICE	--- GAS
⊗ WATER VALVE	⊗ FIRE HYDRANT	--- ENCUMBRANCE

**NOT TO SCALE**