



CITY OF
PRINCE GEORGE

City of Prince George HISTORY SHEET

| | |
|--------|-------------|
| PID: | 030-301-297 |
| SD/MU: | SD100461 |
| WO: | |

CIVIC ADDRESS: 6307 RITA PLACE


LEGAL DESCRIPTION: LOT 1 DISTRICT LOT 4028 PLAN EPP68896

| SERVICE TYPE | DIAMETER (mm) | MATERIAL | INVERT ELEV AT MAIN (m) | INVERT ELEV AT PROPERTY LINE (m) | INVERT ELEV AT SERVICE END (m) | COVER AT PROPERTY LINE (m) | DISTANCE INTO PROPERTY (m) | INSTALLATION DATE |
|--------------|---------------|----------|-------------------------|----------------------------------|--------------------------------|----------------------------|----------------------------|-------------------|
| SANITARY | 100 | PVC | 729.14 | 729.28 | 729.33 | 2.32 | 3.00 | JULY 2015 |
| WATER | 19 | COPPER | 729.04 | 729.29 | 729.24 | 2.37 | 3.00 | JULY 2015 |
| STORM | 100 | PVC | 729.07 | 729.27 | 729.32 | 2.32 | 3.00 | JULY 2015 |

| ELECTRICAL / COMMUNICATIONS / GAS | | | |
|-----------------------------------|----------|-------------------|-----------------------------------|
| TYPE | PROVIDER | SIZE AND MATERIAL | LOCATION (UNDERGROUND/ OVERHEAD) |
| ELECTRICAL | BC HYDRO | 75mm DB2 | UNDERGROUND |
| COMMUNICATION | TELUS | 50mm DB2 | UNDERGROUND |
| COMMUNICATION | SHAW | 50mm DB2 | UNDERGROUND |
| GAS | FORTISBC | 42 PROP/P.E. | UNDERGROUND |

| | |
|--|------------------------|
| INFORMATION SHEETS: L&M ENGINEERING LIMITED PROJECT NUMBER 1515-01 | SURVEY DATE: JULY 2015 |
| INSTALLED BY: MIKE SIMMS | |
| COMMENTS: SANITARY, STORM AND WATER MAIN WERE INSTALLED IN 1997 | |

THE INFORMATION CONTAINED HEREIN IS FOR INTERNAL USE ONLY.
NOT TO BE RELIED UPON UNLESS CONFIRMED BY SITE INVESTIGATION.

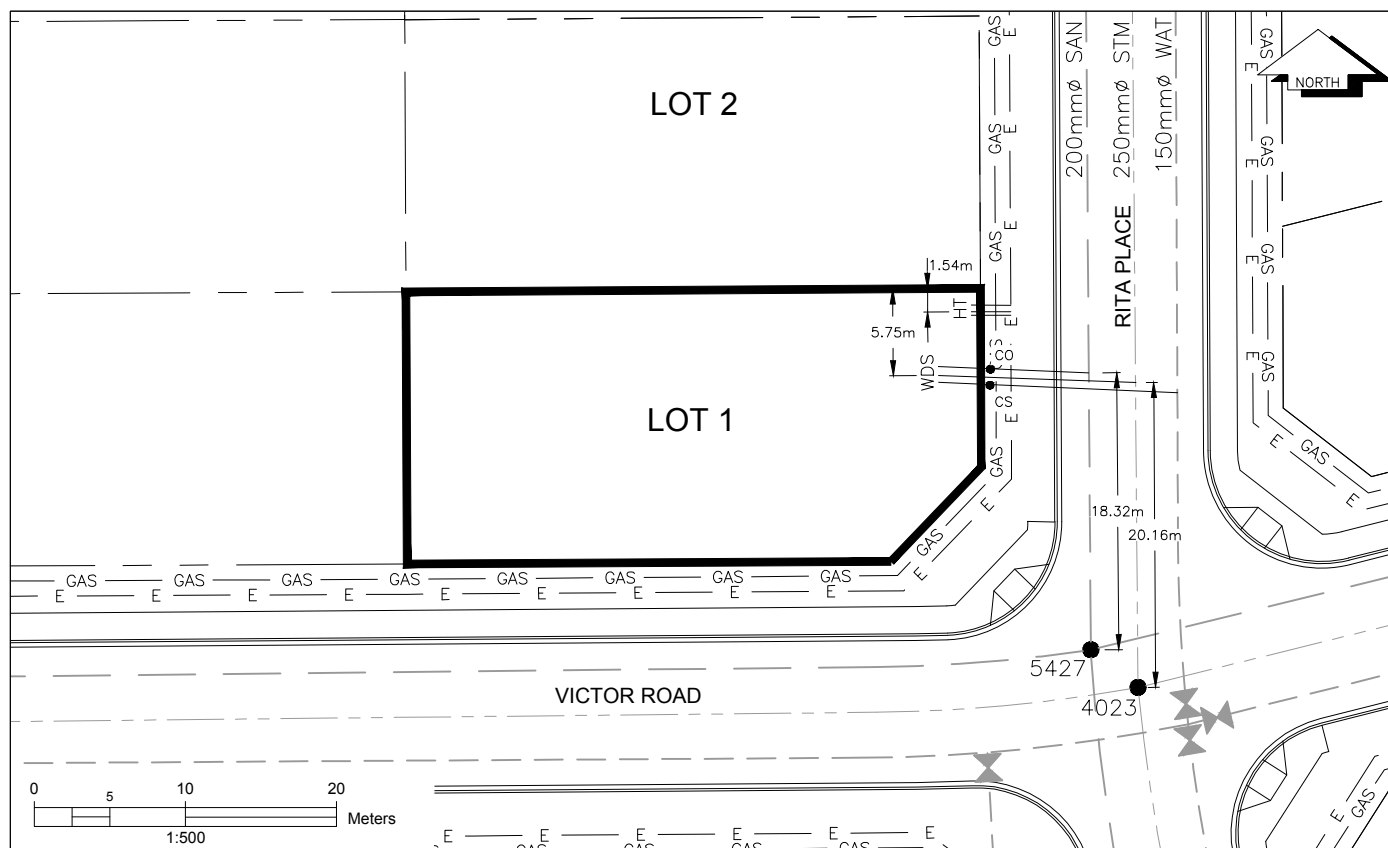

| LEGEND: | | CS CURB STOP | CO CLEAN OUT | W WATER SERVICE | D STORM SERVICE | S SANITARY SERVICE | H HYDRO SERVICE | T TELECOMMUNICATIONS | GAS GAS | E ELECTRICAL |
|---------|--|--------------|--------------|-----------------|-----------------|--------------------|-----------------|----------------------|---------|--------------|
|---------|--|--------------|--------------|-----------------|-----------------|--------------------|-----------------|----------------------|---------|--------------|