



City of Prince George History Sheet

PID:	030301301
SD:	100461
WO:	

Civic Address: 6319 Rita Pl

Legal Description: Lot: 2 District Lot: 4028 Plan: EPP68896


Service Type	Diameter (mm)	Material	Invert Elev at main (m)	Invert Elev at property line (m)	Invert Depth at service end (m)	Distance into property (m)	Installation Date
Sanitary	100mm	PVC	729.21	729.21	2.41	0.90	July 2015
Water	20mm	Copper	729.03	729.28	2.44	-	July 2015
Storm	100mm	PVC	729.03	729.28	2.44	0.90	July 2015

Service Connection Location				Sanitary (m)	Storm (m)
Distance from downstream San MH	5427	towards upstream San MH	5428	33.95	
Distance from downstream Stm MH	6976	towards upstream Stm MH	4022		34.82

Power	Size	Communications	Size	Cable	Size	Gas	Size
BC Hydro	75mm DB2	Telus	50mm DB2	Shaw	50mm DB2	FortisBC	42PROP/P.E.
Underground Service		Underground Service		Underground Service			

Installed by:	Mike Simms	Survey Date:	-
Comments:	Service locate done in 2018		

NOT TO SCALE The information contained herein is for internal use only.
Not to be relied on unless confirmed by site inspection and/or investigation.

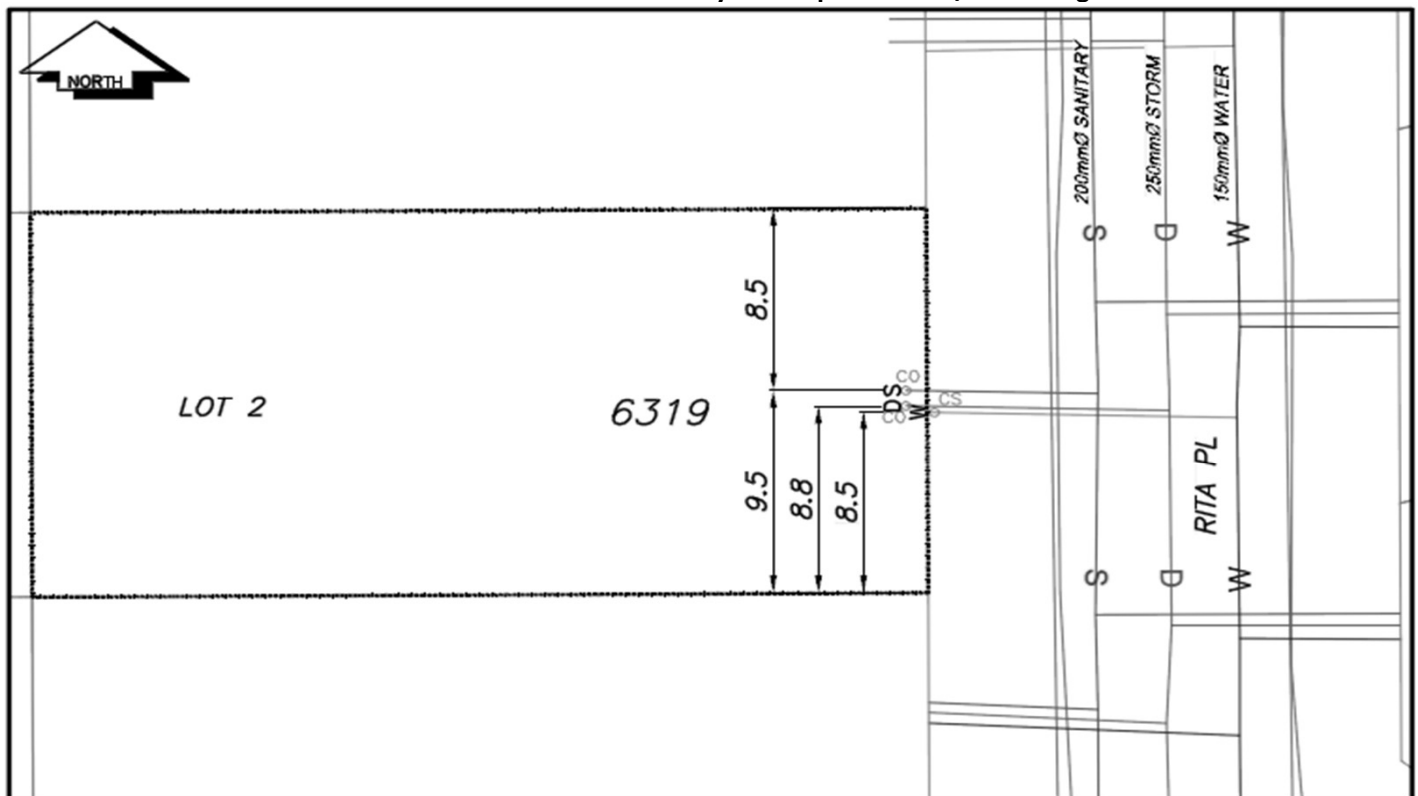

CS ^o CURB STOP	— W — WATER SERVICE	— S — STORM SERVICE
CO ^o CLEAN OUT	— S — SANITARY SERVICE	— G — GAS
⊗ WATER VALVE	⊗ FIRE HYDRANT	— — — ENCUMBRANCE

NOT TO SCALE